

HUGHES DEVELOPMENTS LIMITED

99 ESCOTTS ROAD

TUAKAU

PROJECT NUMBER: 2011-02




CIVILPLAN

CONSULTANTS

STAGE 2 - ASBUILT ISSUE

MARCH 2020

Sheet List Table	
Sheet Number	Sheet Title
2011-02-AB000	COVER SHEET
200-Earthworks	
2011-02-AB205	UNDERFILL DRAINS ASBUILT PLAN
2011-02-AB200	FINISHED CONTOURS ASBUILT PLAN
2011-02-AB220	ISOPACH ASBUILT PLAN-SHEET 1
2011-02-AB225	ISOPACH ASBUILT PLAN-SHEET 2
2011-02-AB290	SLOPE ANALYSIS ASBUILT PLAN-SHEET 1
2011-02-AB291	SLOPE ANALYSIS ASBUILT PLAN-SHEET 2
300-Roading	
2011-02-AB300	ROADING ASBUILT-PAVEMENT PLAN-SHEET 1
2011-02-AB301	ROADING ASBUILT-PAVEMENT PLAN-SHEET 2
2011-02-AB302	ROADING ASBUILT-FEATURES PLAN-SHEET 1
2011-02-AB303	ROADING ASBUILT-FEATURES PLAN-SHEET 2
400-Drainage	
2011-02-AB400	STORMWATER ASBUILT-OVERALL LAYOUT
2011-02-AB401	STORMWATER ASBUILT-DETAIL SHEET 1
2011-02-AB402	STORMWATER ASBUILT-DETAIL SHEET 2
2011-02-AB403	STORMWATER ASBUILT-DETAIL SHEET 3
2011-02-AB404	STORMWATER ASBUILT-COORDINATE SCHEDULES
2011-02-AB410	WASTEWATER ASBUILT-OVERALL LAYOUT
2011-02-AB411	WASTEWATER ASBUILT-DETAIL SHEET 1
2011-02-AB412	WASTEWATER ASBUILT-DETAIL SHEET 2
2011-02-AB413	WASTEWATER ASBUILT-DETAIL SHEET 3
500-Water Supply	
2011-02-AB500	WATER SUPPLY ASBUILT-OVERALL LAYOUT-SHEET 1
2011-02-AB501	WATER SUPPLY ASBUILT-DETAIL SHEET 1
2011-02-AB502	WATER SUPPLY ASBUILT-DETAIL SHEET 2
2011-02-AB503	WATER SUPPLY ASBUILT-DETAIL SHEET 3
2011-02-AB504	WATER SUPPLY ASBUILT-COORDINATE SCHEDULES
600-Services	
2011-02-AB600	POWER SUPPLY ASBUILT PLAN-STAGE 2-SHEET 1
2011-02-AB601	POWER SUPPLY ASBUILT PLAN-STAGE 2-SHEET 2
2011-02-AB610	CHORUS ASBUILT PLAN-SHEET 1
2011-02-AB611	CHORUS ASBUILT PLAN-SHEET 2

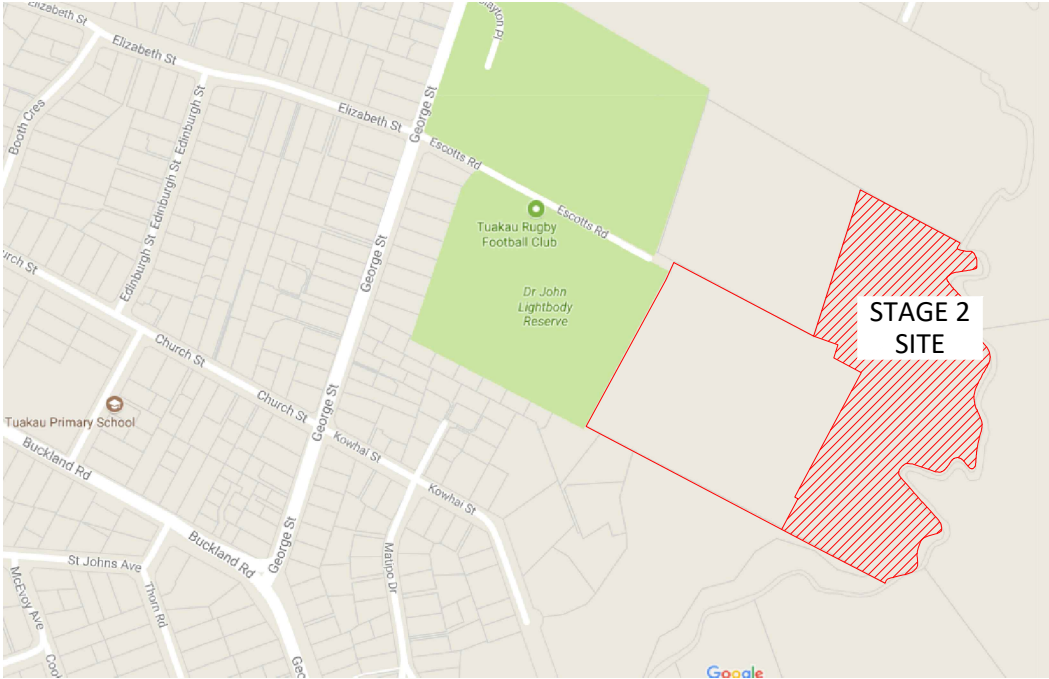

SCHEDULE OF COORDINATES			
POINT No.	mE	mN	LEVEL
UF 3.01	416532.79	757295.37	29.42
UF 3.02	416531.51	757293.98	29.45
UF 3.03	416531.76	757292.71	29.35
UF 3.04	416533.50	757291.63	29.19
UF 3.05	416537.29	757290.90	29.05
UF 3.06	416541.10	757288.21	28.96
UF 3.07	416546.75	757285.79	28.75
UF 3.08	416550.14	757286.12	28.62
UF 3.09	416552.67	757284.88	28.73
UF 3.10	416557.56	757283.01	28.62
UF 4.01	416533.06	757267.83	29.28
UF 4.02	416532.07	757263.07	29.18
UF 4.03	416532.27	757259.04	29.12
UF 4.04	416535.58	757255.86	28.83
UF 4.05	416539.61	757252.99	28.46
UF 4.06	416545.04	757249.37	28.24
UF 4.07	416553.21	757241.77	27.70
UF 5.01	416534.85	757171.21	29.87
UF 5.02	416535.76	757170.61	29.70
UF 5.03	416540.26	757170.77	28.75
UF 5.04	416543.32	757171.89	28.70
UF 5.05	416545.77	757175.09	28.70
UF 5.06	416547.28	757178.48	28.70
UF 5.07	416547.77	757182.78	28.66
UF 5.08	416547.15	757189.61	28.61
UF 5.09	416547.68	757191.29	28.66
UF 5.10	416553.69	757194.65	28.26
UF 5.11	416561.45	757197.66	27.90
UF 5.12	416569.27	757199.34	27.76
UF 5.13	416537.40	757186.18	29.78
UF 5.14	416538.68	757191.11	29.57
UF 5.15	416543.81	757190.54	28.95
UF 5.16	416538.51	757197.07	30.01
CF 1.1	416483.95	757047.28	26.80
CF 1.2	416496.83	757046.22	26.53
CF 2.1	416487.84	757058.33	26.70
CF 2.2	416499.01	757049.70	26.29
CF 3.1	416493.96	757064.77	26.50
CF 3.2	416500.47	757052.40	26.41
CF 4.1	416505.92	757067.04	26.26
CF 4.2	416506.50	757056.40	26.15

SCHEDULE OF COORDINATES			
POINT No.	mE	mN	LEVEL
UF 3.01	416532.79	757295.37	29.42
UF 3.02	416531.51	757293.98	29.45
UF 3.03	416531.76	757292.71	29.35
UF 3.04	416533.50	757291.63	29.19
UF 3.05	416537.29	757290.90	29.05
UF 3.06	416541.10	757288.21	28.96
UF 3.07	416546.75	757285.79	28.75
UF 3.08	416550.14	757286.12	28.62
UF 3.09	416552.67	757284.88	28.73
UF 3.10	416557.56	757283.01	28.62
UF 4.01	416533.06	757267.83	29.28
UF 4.02	416532.07	757263.07	29.18
UF 4.03	416532.27	757259.04	29.12
UF 4.04	416535.58	757255.86	28.83
UF 4.05	416539.61	757252.99	28.46
UF 4.06	416545.04	757249.37	28.24
UF 4.07	416553.21	757241.77	27.70
UF 5.01	416534.85	757171.21	29.87
UF 5.02	416535.76	757170.61	29.70
UF 5.03	416540.26	757170.77	28.75
UF 5.04	416543.32	757171.89	28.70
UF 5.05	416545.77	757175.09	28.70
UF 5.06	416547.28	757178.48	28.70
UF 5.07	416547.77	757182.78	28.66
UF 5.08	416547.15	757189.61	28.61
UF 5.09	416547.68	757191.29	28.66
UF 5.10	416553.69	757194.65	28.26
UF 5.11	416561.45	757197.66	27.90
UF 5.12	416569.27	757199.34	27.76
UF 5.13	416537.40	757186.18	29.78
UF 5.14	416538.68	757191.11	29.57
UF 5.15	416543.81	757190.54	28.95
UF 5.16	416538.51	757197.07	30.01
CF 1.1	416483.95	757047.28	26.80
CF 1.2	416496.83	757046.22	26.53
CF 2.1	416487.84	757058.33	26.70
CF 2.2	416499.01	757049.70	26.29
CF 3.1	416493.96	757064.77	26.50
CF 3.2	416500.47	757052.40	26.41
CF 4.1	416505.92	757067.04	26.26
CF 4.2	416506.50	757056.40	26.15

[illegible]

DRAWN: DPK	DATE: 03.20.20
CHECKED: RIP	DATE: 06.03.20
APPROVED: RIP	DATE: 06.03.20

THIS DRAWING (AND DESIGN) REMAINS THE PROPERTY OF CIVILPLAN CONSULTANTS LIMITED. IT MAY NOT BE REPRODUCED OR ALTERED WITHOUT PRIOR AGREEMENT FROM CIVILPLAN CONSULTANTS LIMITED. CIVILPLAN CONSULTANTS LIMITED WILL NOT ACCEPT LIABILITY ARISING FROM UNAUTHORISED USE OF THIS DRAWING.

CIVILPLAN
CONSULTANTS
Level 9, Laidlaw House, 20 Amersham Way, Manukau, Auckland. Phone: 09 222 2445

PROJECT TITLE:

HUGHES DEVELOPMENTS LIMITED
99 ESCOTTS ROAD
TUAKAU

SHEET TITLE:

UNDERFILL DRAINS ASBUILT PLAN
STAGE 2 - DETAIL SHEET 1
SUB0311/18 & LUC0489/18

ISSUE STATUS:	AS BUILT	
SCALE: (A1/A3)	1:750 / 1:1500	
SCALE BAR		
1:1500@A3		
DRAWING NUMBER:	2011-02-AB205	REV: A



LEGEND

- 10.0 ASBUILT CUT ISOPACH
- 10.0 ASBUILT FILL ISOPACH
- EARTHWORKS ZERO CUT/FILL LINE
- ASBUILT UNDERFILL DRAIN
- ASBUILT COUNTERFORT DRAIN
- STAGE BOUNDARY
- CUT** ASBUILT CUT
- FILL** ASBUILT FILL

- NOTES**
- COORDINATES ARE IN TERMS OF GD2000 MT EDEN CIRCUIT.
 - CONSTRUCTION WAS UNDERTAKEN IN 2018, 2019 AND 2020.

I, RYAN JAMES PITKETHLEY, BELIEVE ON REASONABLE GROUNDS THAT THE CUT/FILL DEPTH CONTOURS SHOWN ARE CORRECT BASED ON THE INFORMATION SUPPLIED TO CIVILPLAN BY THE CONTRACTOR FOR THE WORK, TWOMEY CONSTRUCTION LTD.

[Signature]
RYAN JAMES PITKETHLEY
CMENGNZ CPENG
06.03.2020
DATE

Printed by: RYAN@06.03.20 // Filepath: S:\JOBS\2011 - HUGHES DEVELOPMENTS TUAKAU\CAD\ASBUILT\STAGE 2\2011-02-AB220.DWG

CIVILPLAN CONSULTANTS Level 9, Laidlaw House, 20 Amersham Way, Manukau, Auckland. Phone: 09 222 2445		PROJECT TITLE: HUGHES DEVELOPMENTS LIMITED 99 ESCOTTS ROAD TUAKAU	SHEET TITLE: ISOPACH ASBUILT PLAN - STAGE 2 EXISTING SURFACE TO ASBUILT SURFACE SUB0311/18 & LUC0489/18	ISSUE STATUS: AS BUILT SCALE: (A1/A3) 1:750 / 1:1500 SCALE BAR 0 15 30 45 60 75m DRAWING NUMBER: 2011-02-AB220 REV: A								
<table border="1"><tr><td>DRAWN: DKP</td><td>DATE: 03.2020</td></tr><tr><td>CHECKED: RJP</td><td>DATE: 06.03.20</td></tr><tr><td>APPROVED: RJP</td><td>DATE: 06.03.20</td></tr></table> THIS DRAWING (AND DESIGN) REMAINS THE PROPERTY OF CIVILPLAN CONSULTANTS LIMITED AND MAY NOT BE REPRODUCED OR ALTERED WITHOUT PRIOR AGREEMENT FROM CIVILPLAN CONSULTANTS LIMITED. CIVILPLAN CONSULTANTS LIMITED WILL NOT ACCEPT LIABILITY ARISING FROM UNAUTHORISED USE OF THIS DRAWING.		DRAWN: DKP	DATE: 03.2020	CHECKED: RJP	DATE: 06.03.20	APPROVED: RJP	DATE: 06.03.20					
DRAWN: DKP	DATE: 03.2020											
CHECKED: RJP	DATE: 06.03.20											
APPROVED: RJP	DATE: 06.03.20											
<table border="1"><tr><td>A</td><td>AS BUILT ISSUE</td><td>TR</td><td>06.03.20</td></tr><tr><td>REV</td><td>REVISION DETAILS</td><td>BY</td><td>DATE</td></tr></table>		A	AS BUILT ISSUE	TR	06.03.20	REV	REVISION DETAILS	BY	DATE			
A	AS BUILT ISSUE	TR	06.03.20									
REV	REVISION DETAILS	BY	DATE									



LEGEND

- 10.0 EXISTING CONTOUR
- 10.0 ASBUILT MINOR CONTOUR
- 10.0 ASBUILT MAJOR CONTOUR
- EARTHWORK EXTENT
- - - ASBUILT SUB-SOIL DRAIN
- ASBUILT RETAINING WALL
- SLOPES OVER 1 IN 4
- STAGE BOUNDARY

- NOTES**
- COORDINATES ARE IN TERMS OF GD2000 MT EDEN CIRCUIT.
 - CONSTRUCTION WAS UNDERTAKEN IN 2018 AND 2019.

I, RYAN JAMES PITKETHLEY, BELIEVE ON REASONABLE GROUNDS THAT THE CONTOURS SHOWN ARE CORRECT BASED ON THE INFORMATION SUPPLIED TO CIVILPLAN BY THE CONTRACTOR FOR THE WORK, TWOMEY CONSTRUCTION LTD.

R. Pitkethley

RYAN JAMES PITKETHLEY
CMENGZ CPENG

06.03.2020
DATE

Printed by: RYAN@06.03.20 // Filepath: S:\085\2011 - HUGHES DEVELOPMENTS TUAKAU\CAD\ASBUILT\STAGE 2\2011-02-AB290.DWG

A	AS BUILT ISSUE	TR	06.03.20		
REV	REVISION DETAILS	BY	DATE		

DRAWN:	DATE:	
DKP	03.2020	
CHECKED:	DATE:	
RJP	06.03.20	
APPROVED:	DATE:	
RJP	06.03.20	
THIS DRAWING (AND DESIGN) REMAINS THE PROPERTY OF CIVILPLAN CONSULTANTS LIMITED AND MAY NOT BE REPRODUCED OR ALTERED WITHOUT PRIOR AGREEMENT FROM CIVILPLAN CONSULTANTS LIMITED. CIVILPLAN CONSULTANTS LIMITED WILL NOT ACCEPT LIABILITY ARISING FROM UNAUTHORISED USE OF THIS DRAWING.		

CIVILPLAN
CONSULTANTS

Level 9, Laidlaw House, 20 Amersham Way, Manukau, Auckland. Phone: 09 222 2445

PROJECT TITLE:
HUGHES DEVELOPMENTS LIMITED
99 ESCOTTS ROAD
TUAKAU

SHEET TITLE:
SLOPE ANALYSIS ASBUILT PLAN
STAGE 2 - SHEET 1
SUB0311/18 & LUC0489/18

ISSUE STATUS: **AS BUILT**

SCALE: (A1/A3) 1:500 / 1:1000

SCALE BAR: 0 10 20 30 40 50m

DRAWING NUMBER: 2011-02-AB290 REV: A



LEGEND

- 10.0 EXISTING CONTOUR
- 10.0 ASBUILT MINOR CONTOUR
- 10.0 ASBUILT MAJOR CONTOUR
- - - EARTHWORK EXTENT
- - - ASBUILT SUB-SOIL DRAIN
- ASBUILT RETAINING WALL
- SLOPES OVER 1 IN 4
- STAGE BOUNDARY

NOTES

- COORDINATES ARE IN TERMS OF GD2000 MT EDEN CIRCUIT.
- CONSTRUCTION WAS UNDERTAKEN IN 2018 AND 2019.

I, RYAN JAMES PITKETHLEY, BELIEVE ON REASONABLE GROUNDS THAT THE CONTOURS SHOWN ARE CORRECT BASED ON THE INFORMATION SUPPLIED TO CIVILPLAN BY THE CONTRACTOR FOR THE WORK, TWOMEY CONSTRUCTION LTD.

[Signature]

RYAN JAMES PITKETHLEY
CMENGZ CPENG

06.03.2020
DATE

Printed by: RYAN@06.03.20	Filepath: S:\JOBS\2011 - HUGHES DEVELOPMENTS TUAKAU\CAD\ASBUILT\STAGE 2\2011-02-AB290.DWG		
A	AS BUILT ISSUE	TR	06.03.20
REV	REVISION DETAILS	BY	DATE

DRAWN: DKP	DATE: 03.2020
CHECKED: RJP	DATE: 06.03.20
APPROVED: RJP	DATE: 06.03.20

THIS DRAWING (AND DESIGN) REMAINS THE PROPERTY OF CIVILPLAN CONSULTANTS LIMITED AND MAY NOT BE REPRODUCED OR ALTERED WITHOUT PRIOR AGREEMENT FROM CIVILPLAN CONSULTANTS LIMITED. CIVILPLAN CONSULTANTS LIMITED WILL NOT ACCEPT LIABILITY ARISING FROM UNAUTHORISED USE OF THIS DRAWING

CIVILPLAN
CONSULTANTS

Level 9, Laidlaw House, 20 Amersham Way, Manukau, Auckland. Phone: 09 222 2445

PROJECT TITLE:
HUGHES DEVELOPMENTS LIMITED
99 ESCOTTS ROAD
TUAKAU


SHEET TITLE:
SLOPE ANALYSIS ASBUILT PLAN
STAGE 2 - SHEET 2
SUB0311/18 & LUC0489/18

ISSUE STATUS: **AS BUILT**

SCALE: (A1/A3) 1:500 / 1:1000

SCALE BAR: 0 10 20 30 40 50m

DRAWING NUMBER: 2011-02-AB291 REV: A

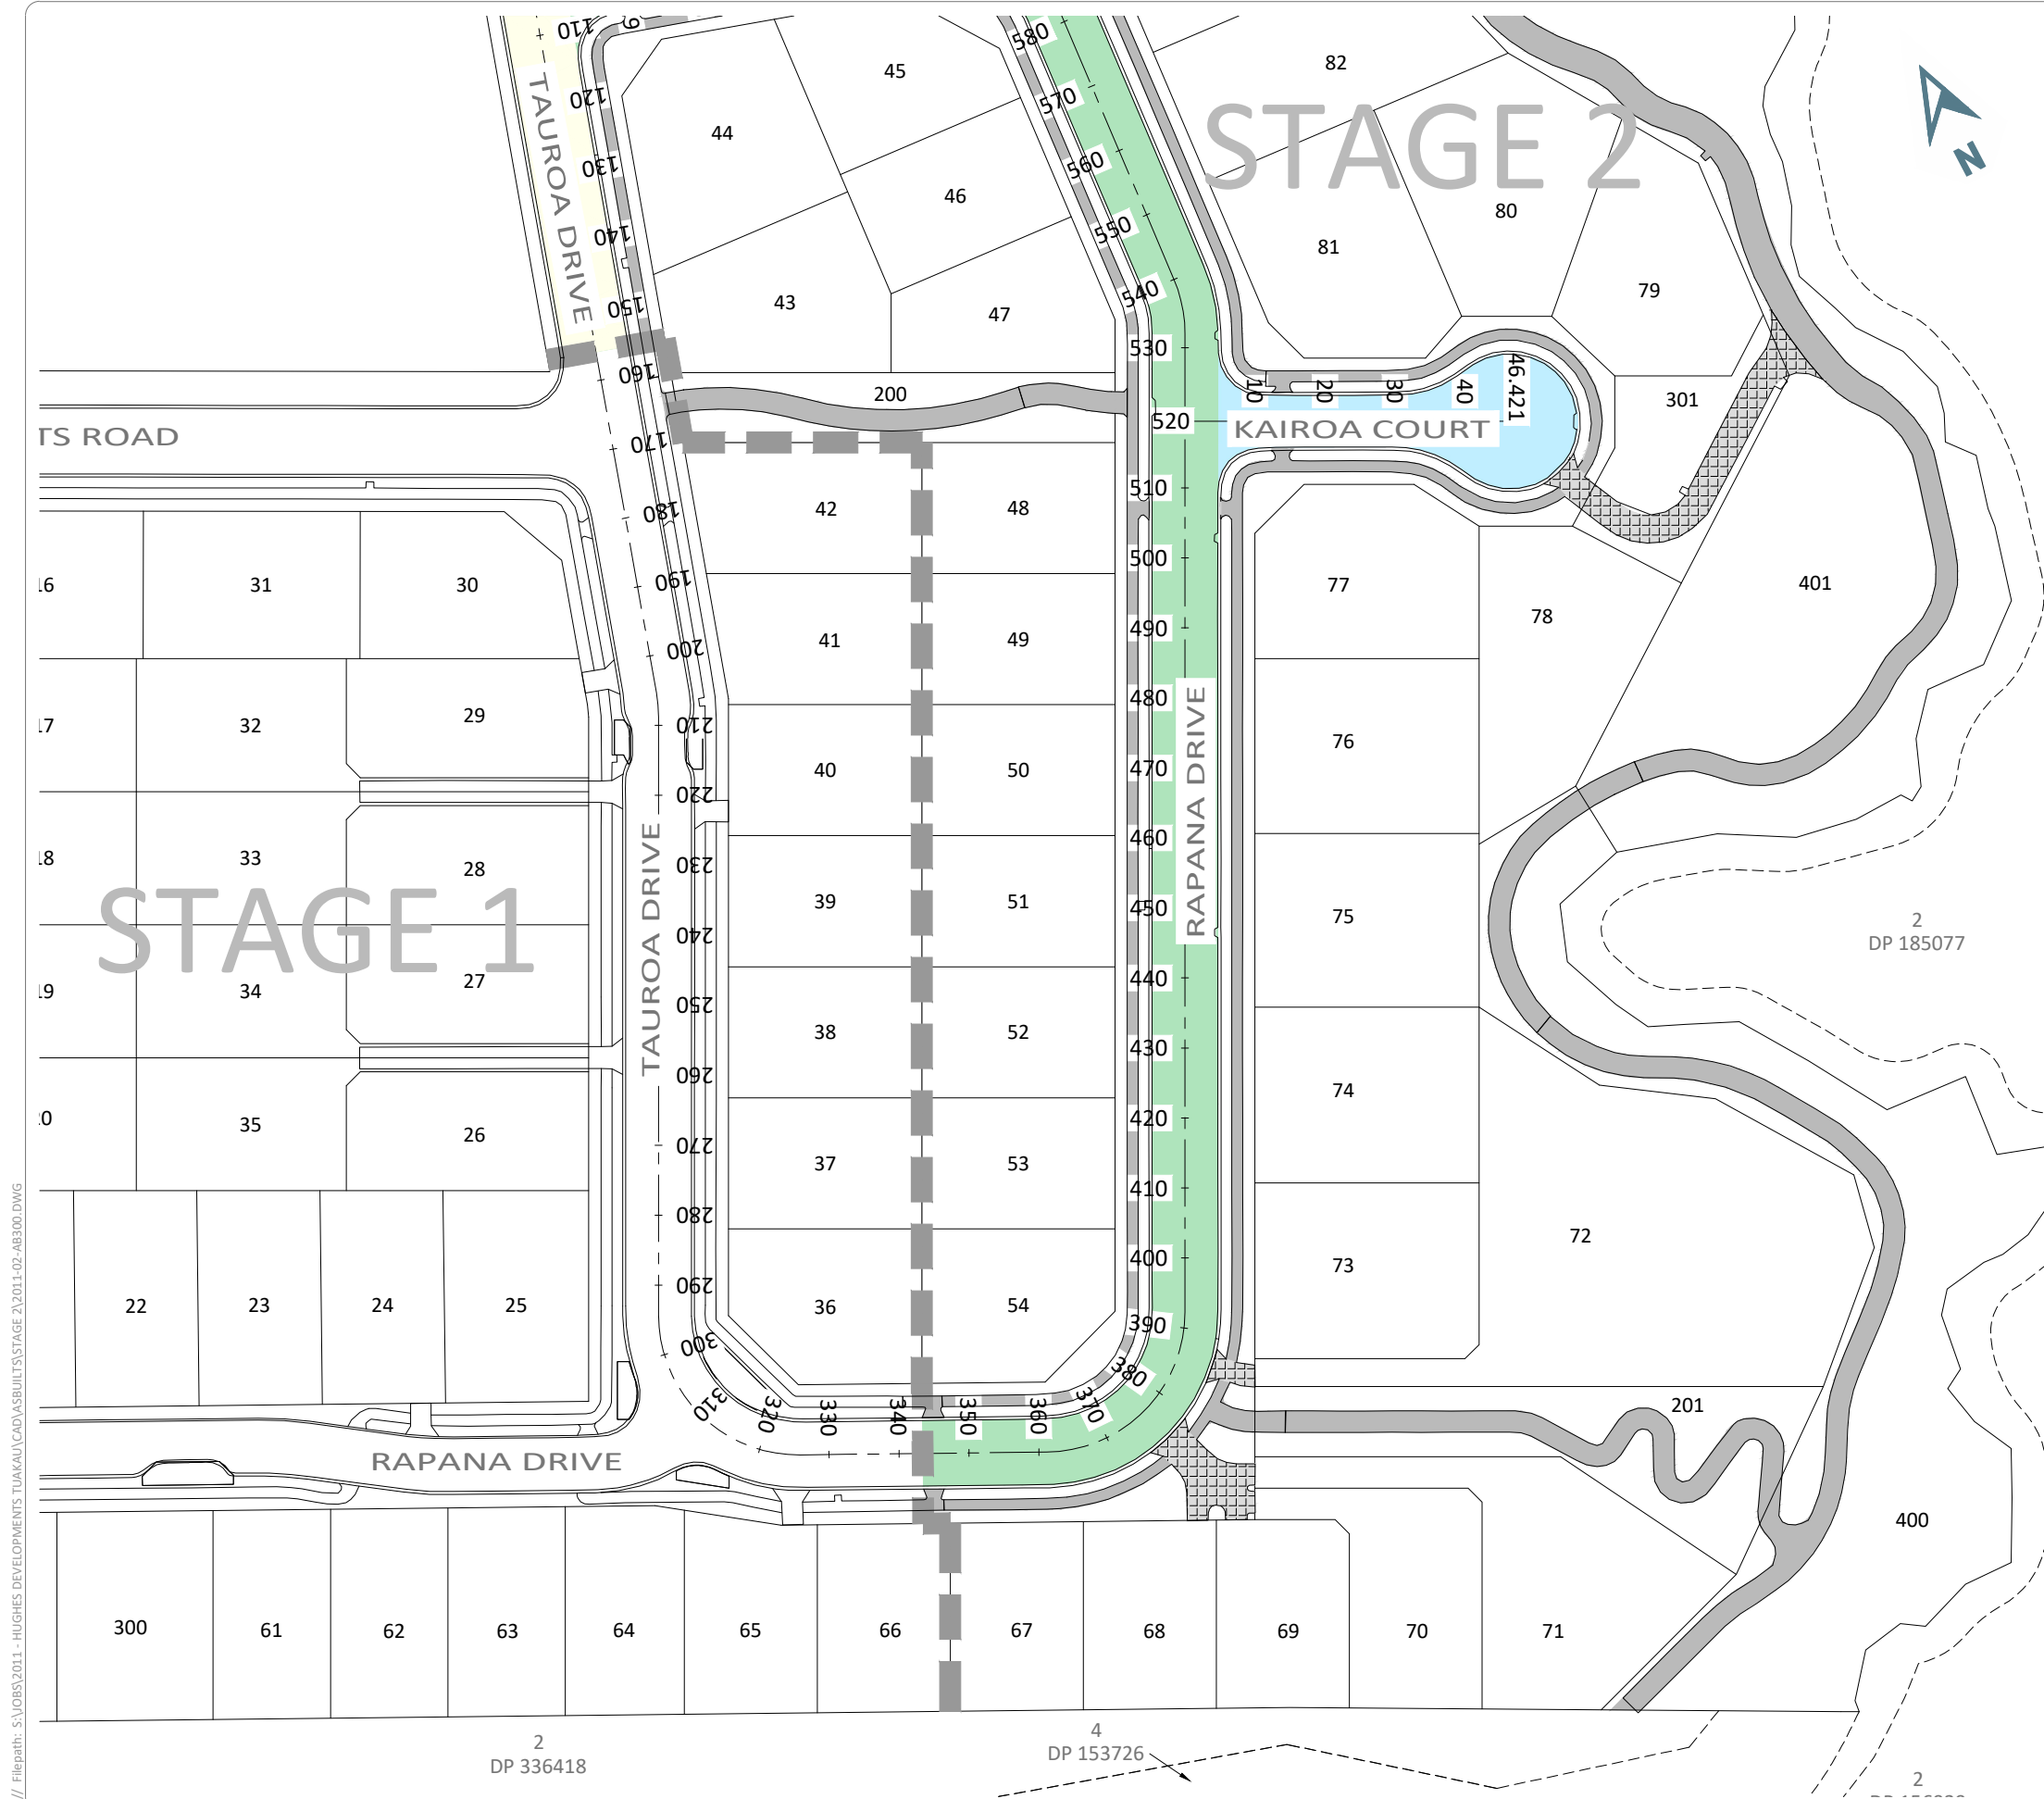

PAVEMENT CONSTRUCTION SCHEDULE				
ROAD	SUBGRADE STRENGTH	SUBBASE DEPTH (mm)	BASECOURSE DEPTH (mm)	SURFACING DEPTH (mm)
ROAD	CBR	GAP 65	AP40 NZTA M/4	DG10 / AC 14
RAPANA DRIVE	5%	250	150	30
KIAROA COURT	5%	250	150	30
TAUROA DRIVE	5%	250	150	30

OTHER CONCRETE	
FOOTPATHS AND RESERVE PATHS	ROAD CROSSINGS AND ACCESSWAYS
NO REINFORCEMENT	1 LAYERS 665 MESH
100 THICK	150 THICK

- NOTES
- COORDINATES ARE IN TERMS OF GD2000 MT EDEN CIRCUIT.
 - CONSTRUCTION WAS UNDERTAKEN IN 2018 AND 2019.
 - ALL ROADS ARE STANDARD CONSTRUCTION WITH NO UNDERCUTS OR GEOTEXTILE.

I, RYAN JAMES PITKETHLEY, BELIEVE ON REASONABLE GROUNDS THAT THE PAVEMENT DEPTHS ARE CORRECT BASED ON THE INFORMATION SUPPLIED TO CIVILPLAN BY THE CONTRACTOR FOR THE WORK, TWOMEY CONSTRUCTION LTD.

[Signature]

RYAN JAMES PITKETHLEY
CMENGNZ CPENG 06.03.2020
DATE

Printed by: RYAN@06.03.20 // Filepath: S:\085\2011 - HUGHES DEVELOPMENTS TUAKAU\CAD\ASBUILT\STAGE 2\2011-02-AB300.DWG

A	AS BUILT ISSUE	TR	06.03.20		
REV	REVISION DETAILS	BY	DATE		

DRAWN:	DATE:	
DKP	03.2020	
CHECKED:	DATE:	
RJP	06.03.20	
APPROVED:	DATE:	
RJP	06.03.20	
THIS DRAWING (AND DESIGN) REMAINS THE PROPERTY OF CIVILPLAN CONSULTANTS LIMITED AND MAY NOT BE REPRODUCED OR ALTERED WITHOUT PRIOR AGREEMENT FROM CIVILPLAN CONSULTANTS LIMITED. CIVILPLAN CONSULTANTS LIMITED WILL NOT ACCEPT LIABILITY ARISING FROM UNAUTHORISED USE OF THIS DRAWING.		

CIVILPLAN
CONSULTANTS
Level 9, Laidlaw House, 20 Amersham Way, Manukau, Auckland. Phone: 09 222 2445

PROJECT TITLE:
HUGHES DEVELOPMENTS LIMITED
99 ESCOTTS ROAD
TUAKAU

SHEET TITLE:
ROADING PAVEMENT ASBUILT PLAN
STAGE 2 - SHEET 1
SUB0311/18 & LUC0489/18

ISSUE STATUS:
SCALE: (A1/A3) 1:500 / 1:1000
SCALE BAR 0 10 20 30 40 50m
DRAWING NUMBER: 2011-02-AB300 REV: A

Printed by: RYAN@06.03.20 // Filepath: S:\JOBS\2011 - HUGHES DEVELOPMENTS TUAKAU\CAD\ASBUILT\STAGE 2\2011-02-AB300.DWG



PAVEMENT CONSTRUCTION SCHEDULE				
ROAD	SUBGRADE STRENGTH	SUBBASE DEPTH (mm)	BASECOURSE DEPTH (mm)	SURFACING DEPTH (mm)
ROAD	CBR	GAP 65	AP40 NZTA M/4	DG10 / AC 14
RAPANA DRIVE	5%	250	150	30
KIAROA COURT	5%	250	150	30
TAUROA DRIVE	5%	250	150	30

OTHER CONCRETE	
FOOTPATHS AND RESERVE PATHS	ROAD CROSSINGS AND ACCESSWAYS
NO REINFORCEMENT	1 LAYERS 665 MESH
100 THICK	150 THICK

- NOTES
- COORDINATES ARE IN TERMS OF GD2000 MT EDEN CIRCUIT.
 - CONSTRUCTION WAS UNDERTAKEN IN 2018 AND 2019.
 - ALL ROADS ARE STANDARD CONSTRUCTION WITH NO UNDERCUTS OR GEOTEXTILE.

I, RYAN JAMES PITKETHLEY, BELIEVE ON REASONABLE GROUNDS THAT THE PAVEMENT DEPTHS ARE CORRECT BASED ON THE INFORMATION SUPPLIED TO CIVILPLAN BY THE CONTRACTOR FOR THE WORK, TWOMEY CONSTRUCTION LTD.

RYAN JAMES PITKETHLEY
CMENGNZ CPENG
06.03.2020
DATE

REV	AS BUILT ISSUE	TR	DATE
A	AS BUILT ISSUE	TR	06.03.20

DRAWN: DKP	DATE: 03.2020
CHECKED: RJP	DATE: 06.03.20
APPROVED: RJP	DATE: 06.03.20

THIS DRAWING (AND DESIGN) REMAINS THE PROPERTY OF CIVILPLAN CONSULTANTS LIMITED AND MAY NOT BE REPRODUCED OR ALTERED WITHOUT PRIOR AGREEMENT FROM CIVILPLAN CONSULTANTS LIMITED. CIVILPLAN CONSULTANTS LIMITED WILL NOT ACCEPT LIABILITY ARISING FROM UNAUTHORISED USE OF THIS DRAWING

CIVILPLAN
CONSULTANTS
Level 9, Laidlaw House, 20 Amersham Way, Manukau, Auckland. Phone: 09 222 2445

PROJECT TITLE:
HUGHES DEVELOPMENTS LIMITED
99 ESCOTTS ROAD
TUAKAU

SHEET TITLE:
ROADING PAVEMENT ASBUILT PLAN
STAGE 2 - SHEET 2
SUB0311/18 & LUC0489/18


ISSUE STATUS: **AS BUILT**

SCALE: (A1/A3) 1:500 / 1:1000

SCALE BAR 0 10 20 30 40 50m

DRAWING NUMBER: 2011-02-AB301 REV: A

Printed by: RYAN@06.03.20 // Filepath: S:\JOBS\2011 - HUGHES DEVELOPMENTS TUAKAU\CAD\ASBUILT\STAGE 2\2011-02-AB302.DWG

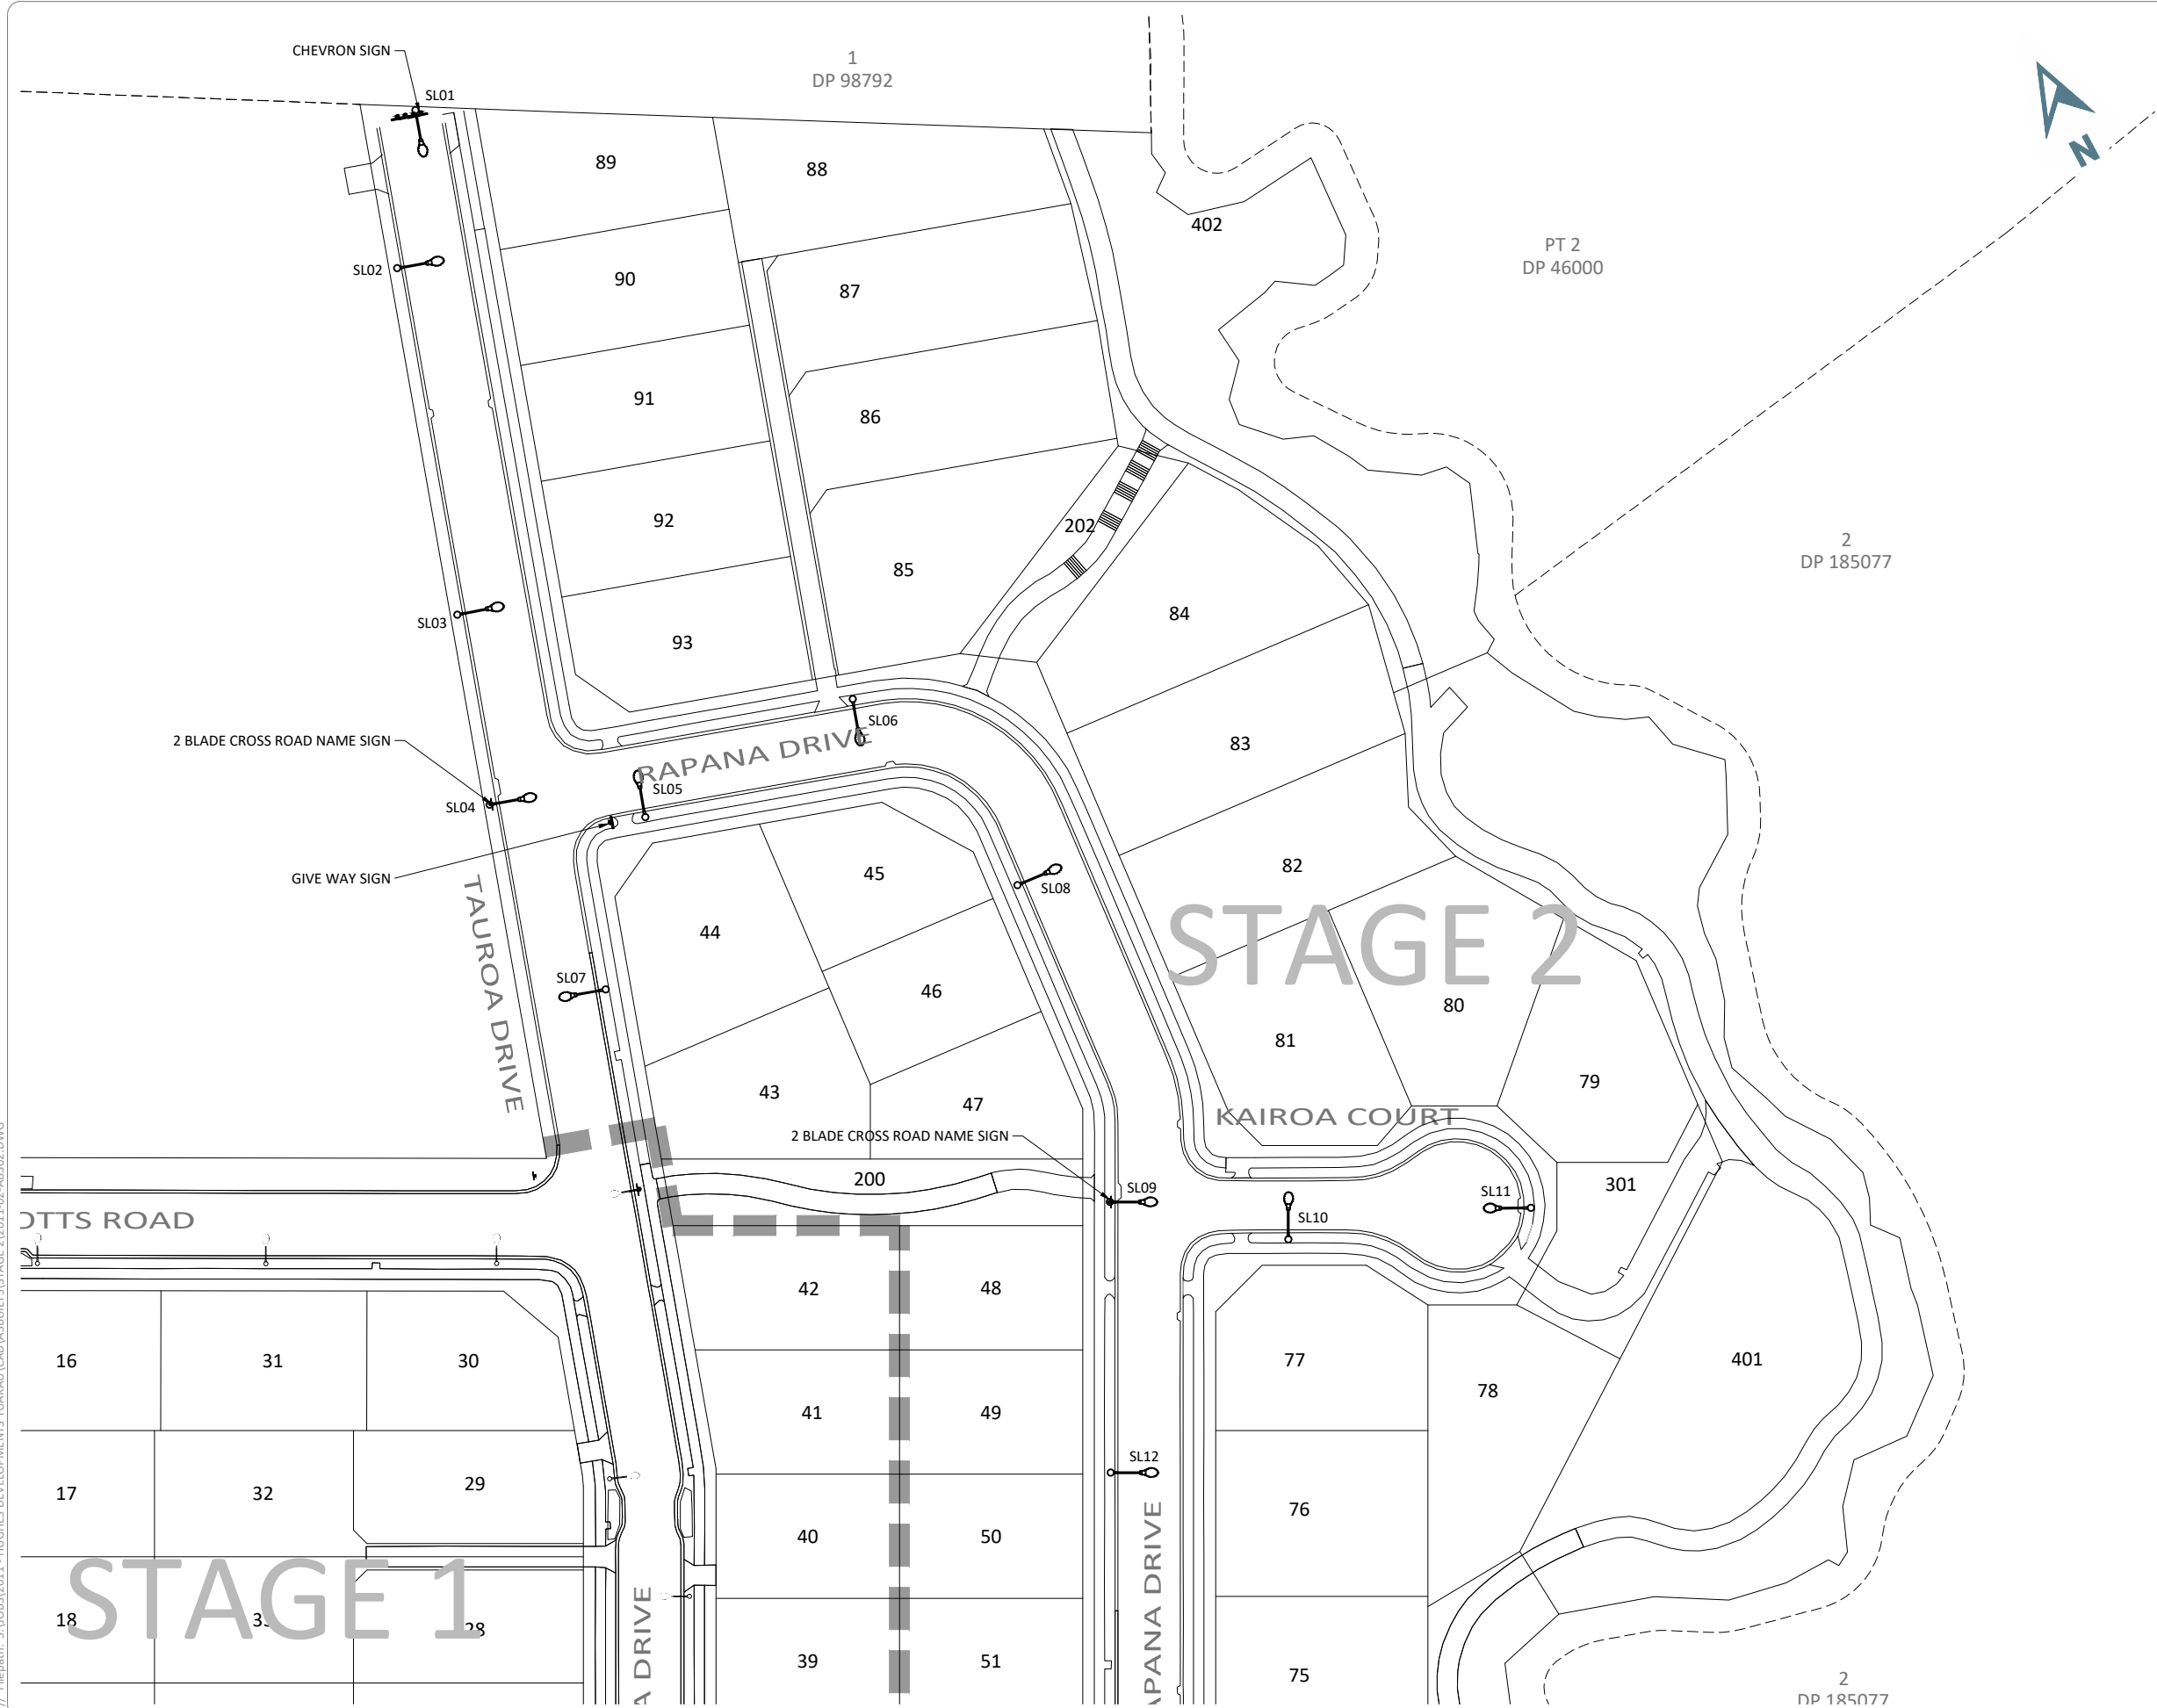

LEGEND

ASBUILT

- STREETLIGHT
- 2 BLADE CROSS ROAD NAME SIGN
- STREET SIGN
- PW-68 CHEVRON SIGN
- STAGE BOUNDARY

NOTES

- COORDINATES ARE IN TERMS OF GD2000 MT EDEN CIRCUIT.
- CONSTRUCTION WAS UNDERTAKEN IN 2019 AND 2020.
- SL1-9,12-15 STREETLIGHT DETAILS:
 - 8m VISULO - MINI STALK (IBEX LIGHTING)
 - 1m OUTREACH
 - 27.5 WATT EACH
 - ZERO DEGREE TILT ANGLE
 - CIRCULAR GALVANISED POLE, PAINTED BLACK
- SL10,11 STREETLIGHT DETAILS:
 - 8m VISULO - MINI STALK (IBEX LIGHTING)
 - 1m OUTREACH
 - 22.3 WATT EACH
 - ZERO DEGREE TILT ANGLE
 - CIRCULAR GALVANISED POLE, PAINTED BLACK

I, RYAN JAMES PITKETHLEY, BELIEVE ON REASONABLE GROUNDS THAT THE STREET LIGHTING, SIGN POSITIONS AND ROAD MARKINGS ARE CORRECT BASED ON THE INFORMATION SUPPLIED TO CIVILPLAN BY THE CONTRACTOR FOR THE WORK, TWOMEY CONSTRUCTION LTD.

RYAN JAMES PITKETHLEY
CMENGNZ CPENG

06.03.2020
DATE

REV	AS BUILT ISSUE	TR	DATE
A	AS BUILT ISSUE	TR	06.03.20
REV	REVISION DETAILS	BY	DATE

DRAWN: DKP	DATE: 03.2020
CHECKED: RJP	DATE: 06.03.20
APPROVED: RJP	DATE: 06.03.20
THIS DRAWING (AND DESIGN) REMAINS THE PROPERTY OF CIVILPLAN CONSULTANTS LIMITED AND MAY NOT BE REPRODUCED OR ALTERED WITHOUT PRIOR AGREEMENT FROM CIVILPLAN CONSULTANTS LIMITED. CIVILPLAN CONSULTANTS LIMITED WILL NOT ACCEPT LIABILITY ARISING FROM UNAUTHORISED USE OF THIS DRAWING.	


CIVILPLAN
CONSULTANTS
Level 9, Laidlaw House, 20 Amersham Way, Manukau, Auckland. Phone: 09 222 2445

PROJECT TITLE:
HUGHES DEVELOPMENTS LIMITED
99 ESCOTTS ROAD
TUAKAU

SHEET TITLE:
ROADING FEATURES ASBUILT PLAN
STAGE 2 - SHEET 2
SUB0311/18 & LUC0489/18

ISSUE STATUS: **AS BUILT**
SCALE: (A1/A3) 1:500 / 1:1000
SCALE BAR 0 10 20 30 40 50m
DRAWING NUMBER: 2011-02-AB303 REV: A

Printed by: RYAN@06.03.20 // Filepath: S:\JOBS\2011 - HUGHES DEVELOPMENTS TUAKAU\CAD\ASBUILT\STAGE 2\2011-02-AB400.DWG

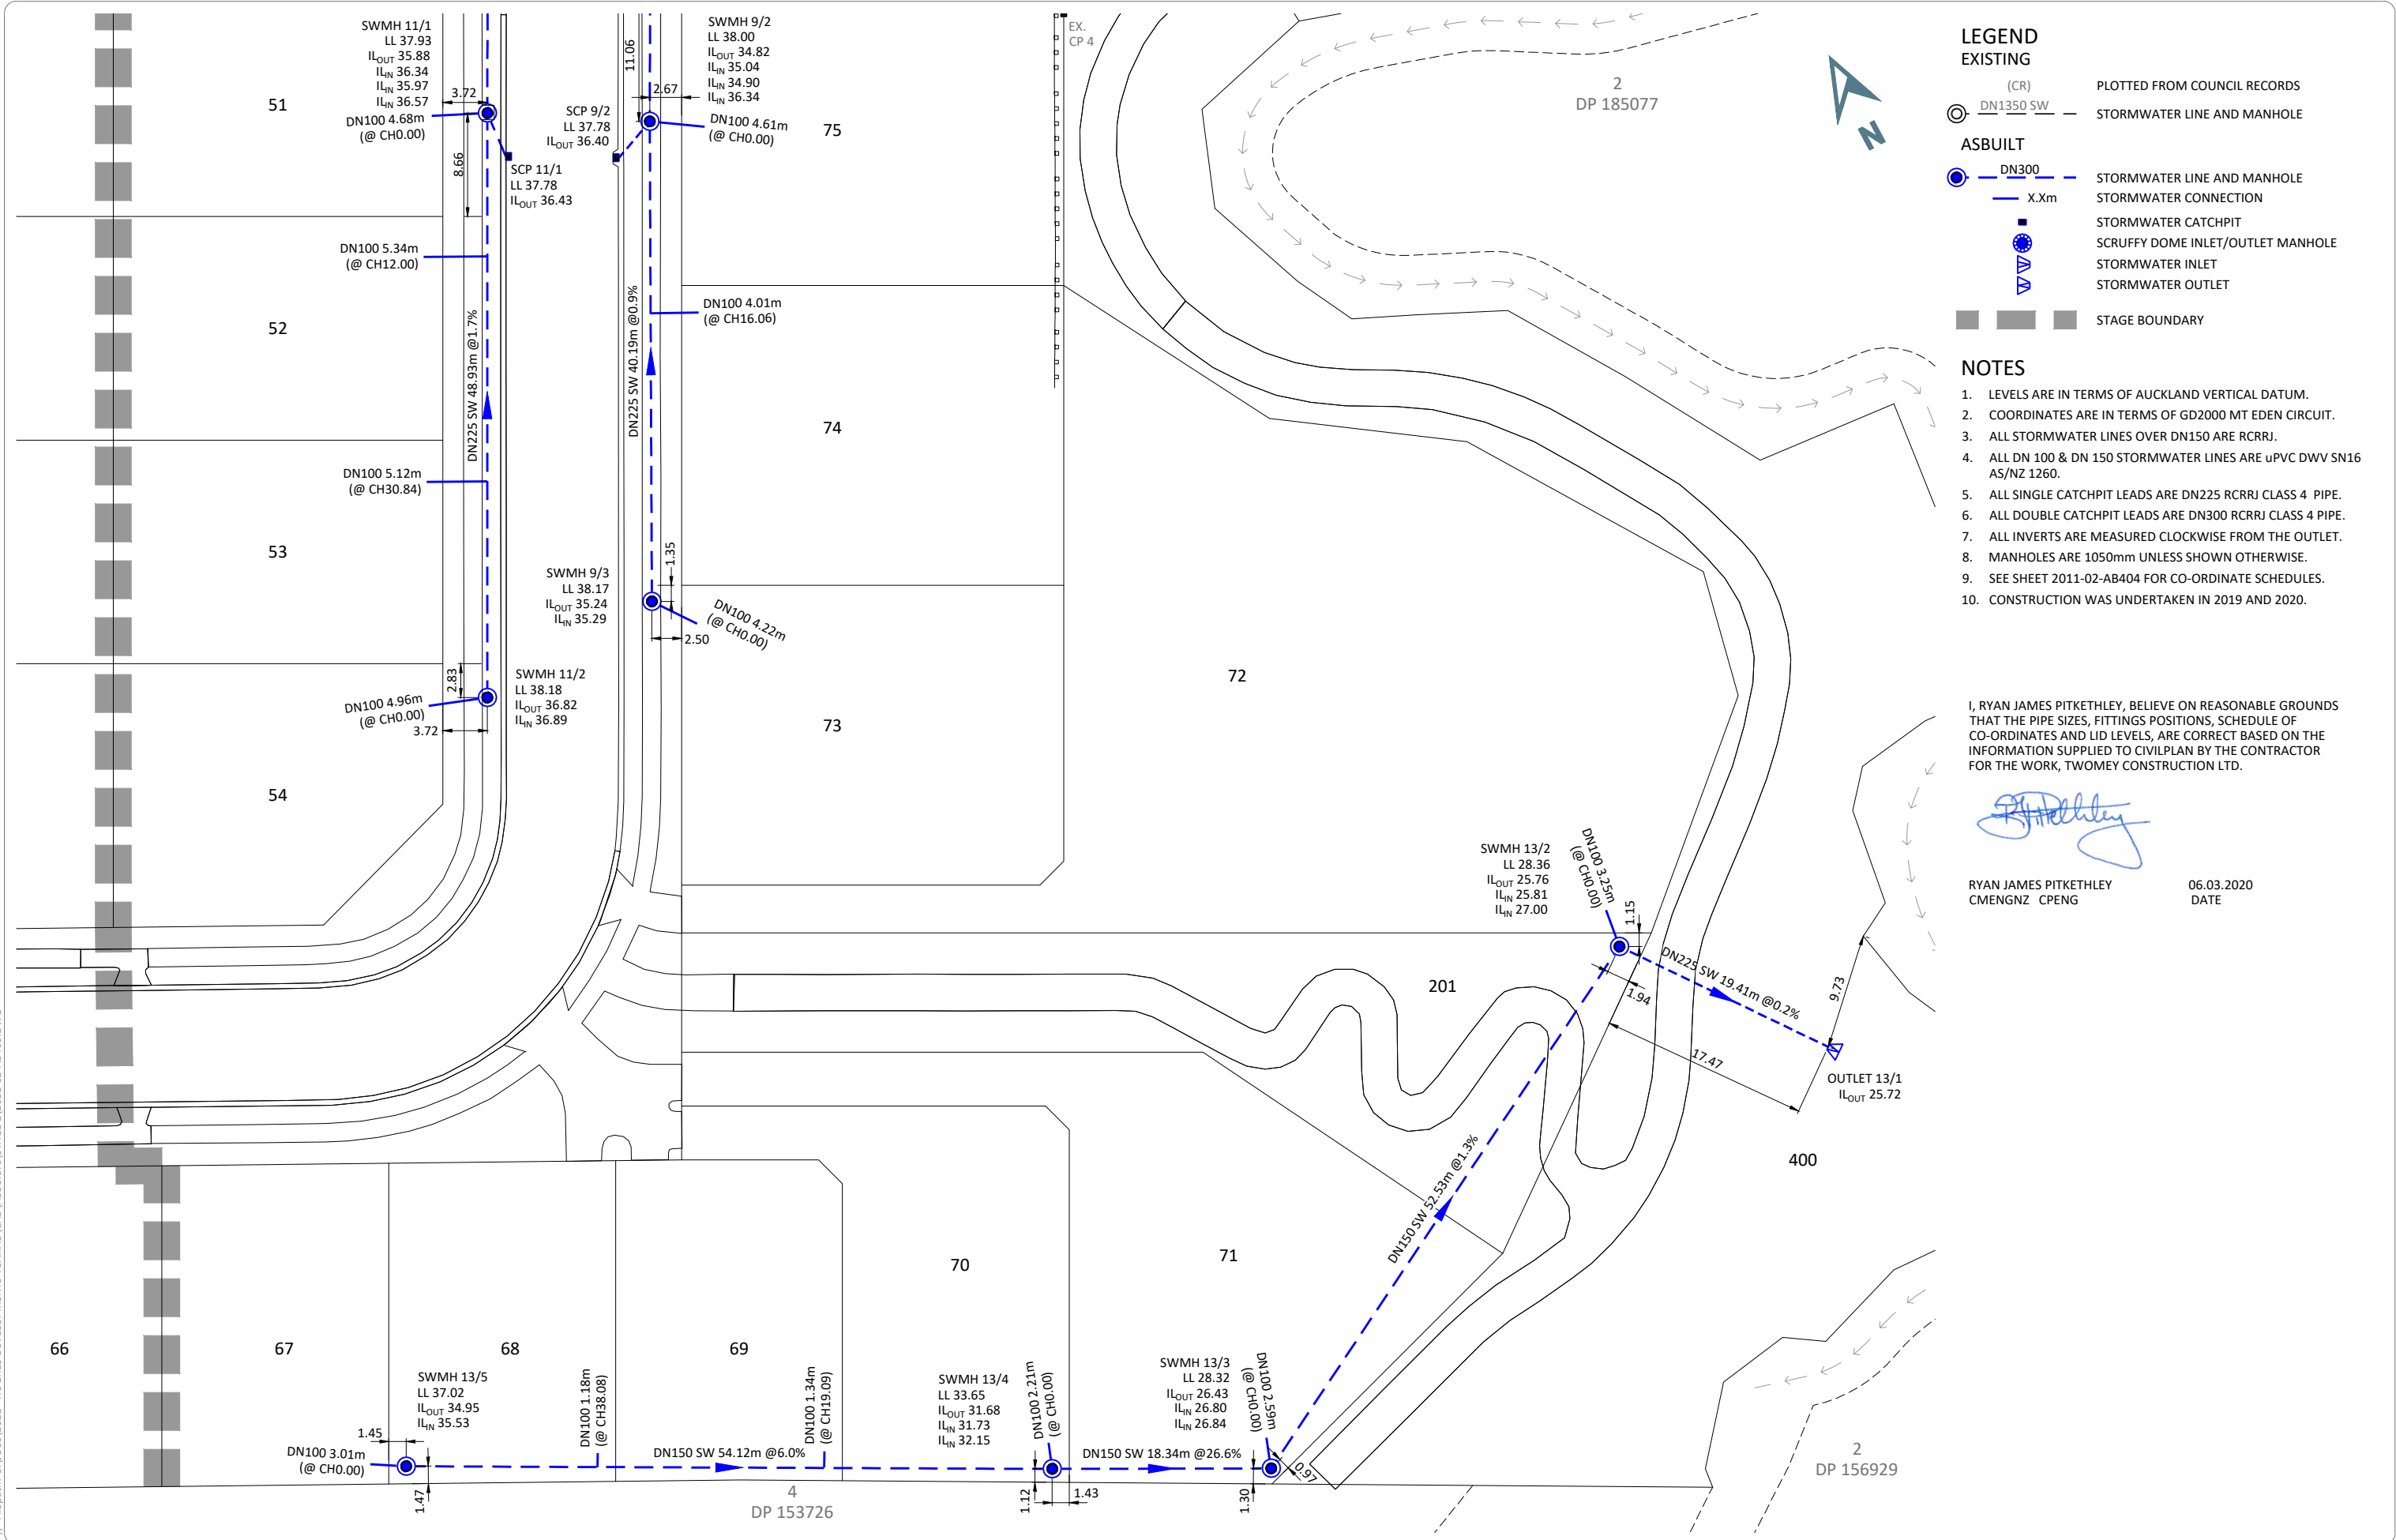

DPK	03.2020				
RJP	06.03.20				
RJP	06.03.20				
AS BUILT ISSUE	TR	06.03.20			
REVISION DETAILS	BY	DATE			

THIS DRAWING (AND DESIGN) REMAINS THE PROPERTY OF CIVILPLAN CONSULTANTS LIMITED AND MAY NOT BE REPRODUCED OR ALTERED WITHOUT PRIOR AGREEMENT FROM CIVILPLAN CONSULTANTS LIMITED. CIVILPLAN CONSULTANTS LIMITED WILL NOT ACCEPT LIABILITY ARISING FROM UNAUTHORISED USE OF THIS DRAWING.

CIVILPLAN
CONSULTANTS
Level 9, Laidlaw House, 20 Amersham Way, Manukau, Auckland. Phone: 09 222 2445

PROJECT TITLE:
HUGHES DEVELOPMENTS LIMITED
99 ESCOTTS ROAD
TUAKAU

SHEET TITLE:
STORMWATER ASBUILT
STAGE 2 - DETAIL SHEET 1
SUB0311/18 & LUC0489/18

ISSUE STATUS:
SCALE: (A1/A3) 1:250 / 1:500
SCALE BAR 1:500@A3
DRAWING NUMBER: 2011-02-AB401
REV: A
AS BUILT

DRAWN: DKP	DATE: 03.2020	
CHECKED: RJP	DATE: 06.03.20	
APPROVED: RJP	DATE: 06.03.20	
THIS DRAWING (AND DESIGN) REMAINS THE PROPERTY OF CIVILPLAN CONSULTANTS LIMITED AND MAY NOT BE REPRODUCED OR ALTERED WITHOUT PRIOR AGREEMENT FROM CIVILPLAN CONSULTANTS LIMITED. CIVILPLAN CONSULTANTS LIMITED WILL NOT ACCEPT LIABILITY ARISING FROM UNAUTHORISED USE OF THIS DRAWING.		

PROJECT TITLE:

HUGHES DEVELOPMENTS LIMITED
99 ESCOTTS ROAD
TUAKAU

ISSUE STATUS: **AS BUILT**

SCALE: (A1/A3) **1:250 / 1:500**

SCALE BAR **0 5 10 15 20 25m**
1:500@A3

DRAWING NUMBER: **2011-02-AB402** REV: **A**

Printed by: RYAN@06.03.20 // Filepath: S:\085\2011 - HUGHES DEVELOPMENTS TUAKAU\CAD\ASBUILT\STAGE 2\2011-02-AB400.DWG

SCHEDULE OF COORDINATES SW MANHOLES-GD2000		
POINT No.	mE	mN
OUTLET 10.1/01	416578.18	757143.26
OUTLET 10/01	416556.31	757171.80
OUTLET 13/01	416507.39	756959.49
OUTLET 7.1/01	416516.70	757057.53
OUTLET 7/01	416561.51	757095.48
SWMH 10.1/02	416578.75	757149.74
SWMH 10/02	416551.01	757170.90
SWMH 10/03	416559.26	757208.47
SWMH 10/04	416539.10	757248.52
SWMH 10/05	416547.31	757278.48
SWMH 11/01	416445.16	757081.37
SWMH 11/02	416422.11	757038.21
SWMH 12/01	416562.29	757149.67
SWMH 13/02	416495.92	756975.15
SWMH 13/03	416449.61	756950.34
SWMH 13/04	416433.42	756958.95
SWMH 13/05	416385.79	756984.64
SWMH 7.1/02	416529.43	757062.93
SWMH 7/010	416464.12	757318.43
SWMH 7/02	416561.19	757104.31
SWMH 7/03	416542.65	757113.52
SWMH 7/04	416496.66	757138.69
SWMH 7/05	416485.01	757155.86
SWMH 7/06	416489.12	757203.81
SWMH 7/07	416486.25	757227.07
SWMH 7/08	416439.47	757242.34
SWMH 7/09	416454.14	757287.88
SWMH 9/01	416484.03	757124.95
SWMH 9/02	416456.83	757074.35
SWMH 9/03	416438.05	757038.82

SCHEDULE OF COORDINATES CATCHPITS-GD2000		
POINT No.	mE	mN
DCP 7/3	416532.66	757113.09
DCP 7/5	416480.34	757143.44
DCP 7/8	416426.44	757241.31
SCP 11/1	416444.82	757077.45
SCP 7/4	416493.27	757148.06
SCP 7/6	416480.16	757216.31
SCP 7/7A	416483.09	757225.36
SCP 7/7B	416479.06	757232.68
SCP 7/9A	416452.96	757292.71
SCP 7/9B	416443.93	757295.69
SCP 9/1	416479.62	757122.57
SCP 9/2	416453.12	757072.88

NOTES

1. LEVELS ARE IN TERMS OF AUCKLAND VERTICAL DATUM.
2. COORDINATES ARE IN TERMS OF GD2000 MT EDEN CIRCUIT.
3. CONSTRUCTION WAS UNDERTAKEN IN 2019 AND 2020.

I, RYAN JAMES PITKETHLEY, BELIEVE ON REASONABLE GROUNDS THAT THE PIPE SIZES, FITTINGS POSITIONS, SCHEDULE OF CO-ORDINATES AND LID LEVELS, ARE CORRECT BASED ON THE INFORMATION SUPPLIED TO CIVILPLAN BY THE CONTRACTOR FOR THE WORK, TWOMEY CONSTRUCTION LTD.

RYAN JAMES PITKETHLEY
CMENGNZ CPENG

06.02.2020
DATE

A	AS BUILT ISSUE		TRS	06.03.20	
REV	REVISION DETAILS		BY	DATE	

DRAWN:	DATE:	
DKP	03.2020	
CHECKED:	DATE:	
RJP	06.03.20	
APPROVED:	DATE:	
RJP	06.03.20	
THIS DRAWING (AND DESIGN) REMAINS THE PROPERTY OF CIVILPLAN CONSULTANTS LIMITED AND MAY NOT BE REPRODUCED OR ALTERED WITHOUT PRIOR AGREEMENT FROM CIVILPLAN CONSULTANTS LIMITED. CIVILPLAN CONSULTANTS LIMITED WILL NOT ACCEPT LIABILITY ARISING FROM UNAUTHORISED USE OF THIS DRAWING.		

CIVILPLAN
CONSULTANTS

Level 9, Laidlaw House, 20 Amersham Way, Manukau, Auckland. Phone: 09 222 2445

PROJECT TITLE:

HUGHES DEVELOPMENTS LIMITED
99 ESCOTTS ROAD
TUAKAU

SHEET TITLE:

STORMWATER ASBUILT
STAGE 2 - COORDINATE SCHEDULES
SUB0311/18 & LUC0489/18

ISSUE STATUS:

AS BUILT

SCALE: (A1/A3) 1:125 / 1:250

SCALE BAR 1:250@A3 0 2.5 5 7.5 10 12.5m

DRAWING NUMBER: 2011-02-AB404 REV: A



LEGEND

EXISTING

(CR)

WASTEWATER LINE AND MANHOLE

ASBUILT

X.Xm

WASTEWATER LINE AND MANHOLE

WASTEWATER CONNECTION

STAGE BOUNDARY

NOTES

1. LEVELS ARE IN TERMS OF AUCKLAND VERTICAL DATUM.

2. COORDINATES ARE IN TERMS OF GD2000 MT EDEN CIRCUIT.

3. ALL WASTEWATER LINES ARE DN150 uPVC SN16 TO AS/NZS1260.

4. ALL WASTEWATER CONNECTIONS ARE DN100 uPVC SN16 TO AS/NZS1260.

5. ALL INVERTS ARE MEASURED CLOCKWISE FROM THE OUTLET.

6. MANHOLES ARE 1050mm UNLESS SHOWN OTHERWISE.

7. CONSTRUCTION WAS UNDERTAKEN IN 2019 AND 2020.

I, RYAN JAMES PITKETHLEY, BELIEVE ON REASONABLE GROUNDS THAT THE PIPE SIZES, FITTINGS POSITIONS, SCHEDULE OF CO-ORDINATES AND LID LEVELS, ARE CORRECT BASED ON THE INFORMATION SUPPLIED TO CIVILPLAN BY THE CONTRACTOR FOR THE WORK, TWOMEY CONSTRUCTION LTD.

RYAN JAMES PITKETHLEY
CMENG NZ CPENG

06.03.2020
DATE

SCHEDULE OF COORDINATES WW MANHOLES-GD2000		
POINT No.	mE	mN
EX. WWMH A/2	416566.83	757138.00
EX. WWMH A/5	416512.97	757112.47
WWMH B/1	416549.50	757170.67
WWMH B/2	416557.73	757208.26
WWMH B/3	416537.73	757248.41
WWMH B/4	416548.17	757286.89
WWMH B/5	416533.15	757295.72
WWMH B/6	416503.37	757312.67
WWMH B/7	416482.64	757249.26
WWMH C/1	416472.15	757134.26
WWMH C/2	416422.47	757041.38
WWMH I/1	416483.47	757156.12
WWMH I/2	416486.94	757192.49
WWMH J/1	416521.46	757128.24

Printed by: RYAN@06.03.20 // Filepath: S:\085\2011 - HUGHES DEVELOPMENTS TUAKAU\CAD\ASBUILT\STAGE 2\2011-02-AB410.DWG

AS BUILT ISSUE

TR5

06.03.20

DATE

DRAWN: DPK

DATE: 03.2020

CHECKED: RJP

DATE: 06.03.20

APPROVED: RJP

DATE: 06.03.20

THIS DRAWING (AND DESIGN) REMAINS THE PROPERTY OF CIVILPLAN CONSULTANTS LIMITED AND MAY NOT BE REPRODUCED OR ALTERED WITHOUT PRIOR AGREEMENT FROM CIVILPLAN CONSULTANTS LIMITED. CIVILPLAN CONSULTANTS LIMITED WILL NOT ACCEPT LIABILITY ARISING FROM UNAUTHORISED USE OF THIS DRAWING.

CIVILPLAN

CONSULTANTS

Level 9, Laidlaw House, 20 Amersham Way, Manukau, Auckland. Phone: 09 222 2445

PROJECT TITLE:

HUGHES DEVELOPMENTS LIMITED
99 ESCOTTS ROAD
TUAKAU

SHEET TITLE:

WASTEWATER ASBUILT
STAGE 2 - OVERALL LAYOUT
SUB0311/18 & LUC0489/18

ISSUE STATUS:

AS BUILT


SCALE: (A1/A3) 1:750 / 1:1500

SCALE BAR 0 15 30 45 60 75m

DRAWING NUMBER: 2011-02-AB410

REV: A

Printed by: RYAN@06.03.20 // Filepath: S:\085\2011 - HUGHES DEVELOPMENTS TUAKAU\CAD\ASBUILT\STAGE 2\2011-02-AB410.DWG

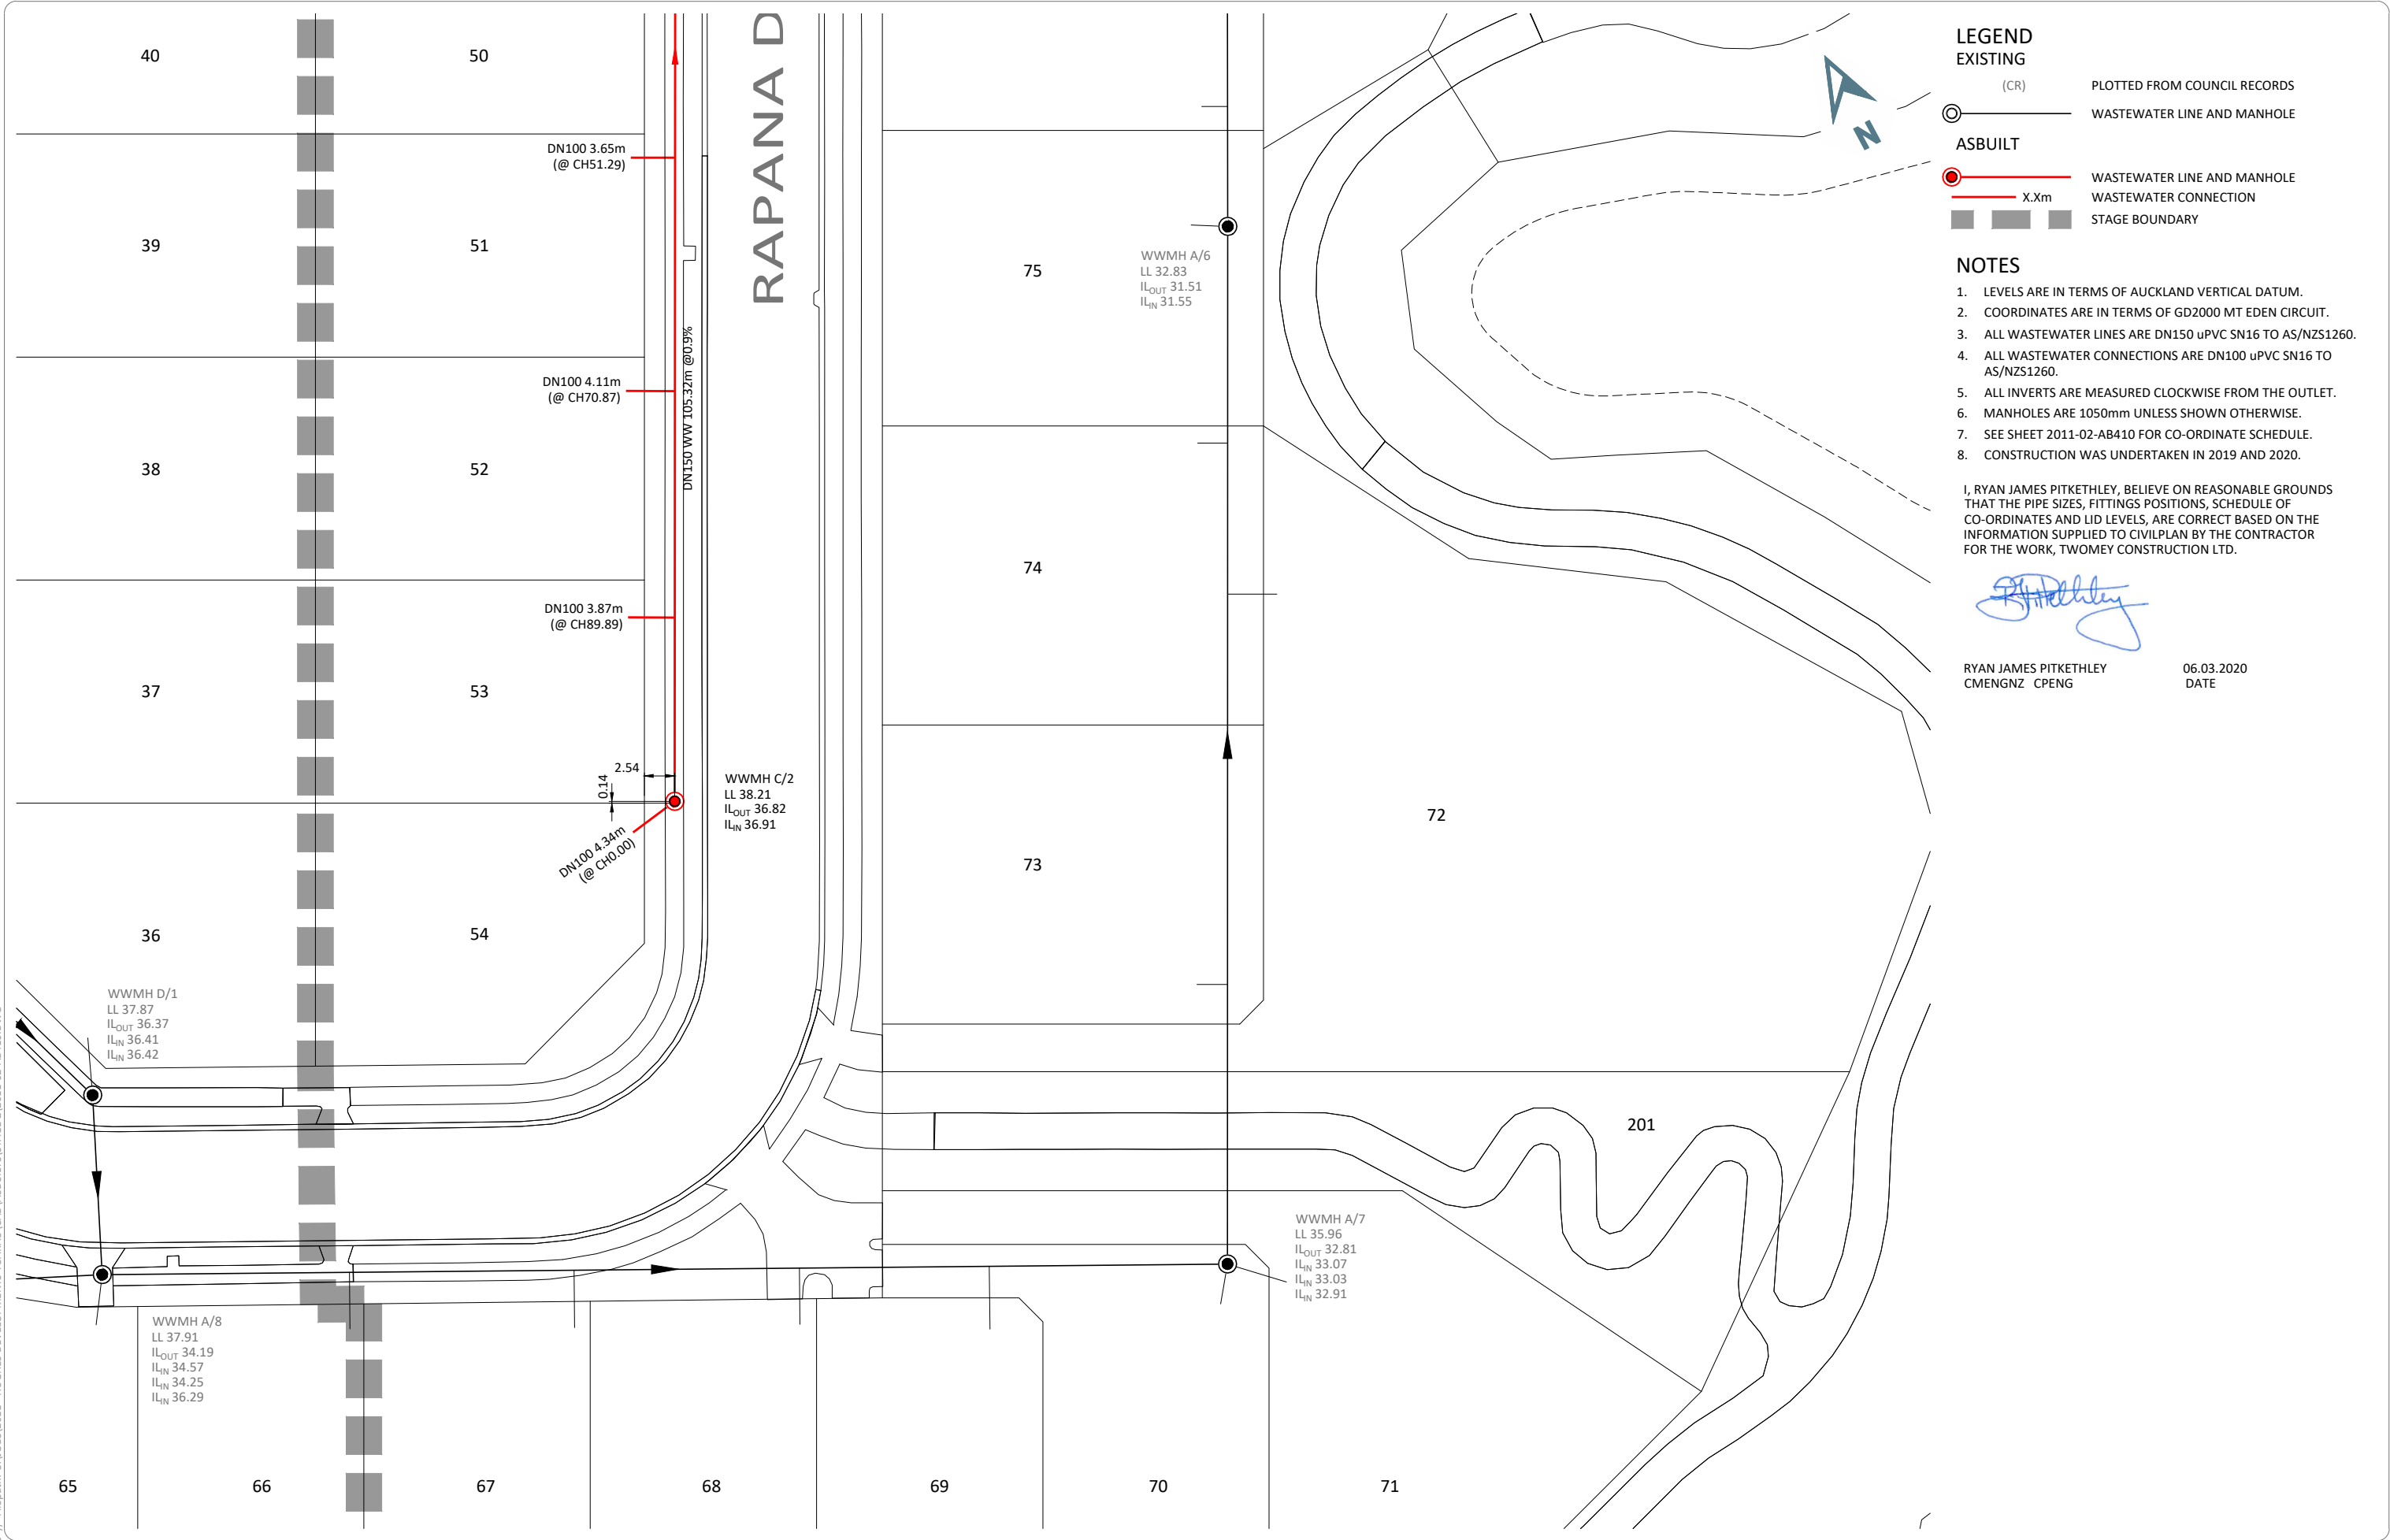

LEGEND

EXISTING

(CR)

ASBUILT

WASTEWATER LINE AND MANHOLE

X.Xm

STAGE BOUNDARY

NOTES

- LEVELS ARE IN TERMS OF AUCKLAND VERTICAL DATUM.
- COORDINATES ARE IN TERMS OF GD2000 MT EDEN CIRCUIT.
- ALL WASTEWATER LINES ARE DN150 uPVC SN16 TO AS/NZS1260.
- ALL WASTEWATER CONNECTIONS ARE DN100 uPVC SN16 TO AS/NZS1260.
- ALL INVERTS ARE MEASURED CLOCKWISE FROM THE OUTLET.
- MANHOLES ARE 1050mm UNLESS SHOWN OTHERWISE.
- SEE SHEET 2011-02-AB410 FOR CO-ORDINATE SCHEDULE.
- CONSTRUCTION WAS UNDERTAKEN IN 2019 AND 2020.

I, RYAN JAMES PITKETHLEY, BELIEVE ON REASONABLE GROUNDS THAT THE PIPE SIZES, FITTINGS POSITIONS, SCHEDULE OF CO-ORDINATES AND LID LEVELS, ARE CORRECT BASED ON THE INFORMATION SUPPLIED TO CIVILPLAN BY THE CONTRACTOR FOR THE WORK, TWOMEY CONSTRUCTION LTD.

Ryan James Pitkethley

RYAN JAMES PITKETHLEY
CMENGNZ CPENG

06.03.2020
DATE

REV	AS BUILT ISSUE	TR	DATE
A	AS BUILT ISSUE	TR	06.03.20
REV	REVISION DETAILS	BY	DATE

DRAWN:	DATE:
DKP	03.2020
CHECKED:	DATE:
RJP	06.03.20
APPROVED:	DATE:
RJP	06.03.20
THIS DRAWING (AND DESIGN) REMAINS THE PROPERTY OF CIVILPLAN CONSULTANTS LIMITED AND MAY NOT BE REPRODUCED OR ALTERED WITHOUT PRIOR AGREEMENT FROM CIVILPLAN CONSULTANTS LIMITED. CIVILPLAN CONSULTANTS LIMITED WILL NOT ACCEPT LIABILITY ARISING FROM UNAUTHORISED USE OF THIS DRAWING.	

CIVILPLAN
CONSULTANTS

Level 9, Laidlaw House, 20 Amersham Way, Manukau, Auckland. Phone: 09 222 2445

PROJECT TITLE:

HUGHES DEVELOPMENTS LIMITED
99 ESCOTTS ROAD
TUAKAU

SHEET TITLE:

WASTEWATER ASBUILT
STAGE 2 - DETAIL SHEET 1
SUB0311/18 & LUC0489/18

ISSUE STATUS:

SCALE: (A1/A3) 1:250 / 1:500

SCALE BAR 1:500@A3

DRAWING NUMBER: 2011-02-AB411 REV: A

AS BUILT

Printed by: RYAN@06.03.20 // Filepath: S:\085\2011 - HUGHES DEVELOPMENTS TUAKAU\CAD\ASBUILT\STAGE 2\2011-02-AB410.DWG

A		AS BUILT ISSUE	TR	06.03.20
REV		REVISION DETAILS	BY	DATE

DRAWN:	DATE:
DKP	03.2020
CHECKED:	DATE:
RJP	06.03.20
APPROVED:	DATE:
RJP	06.03.20
THIS DRAWING (AND DESIGN) REMAINS THE PROPERTY OF CIVILPLAN CONSULTANTS LIMITED AND MAY NOT BE REPRODUCED OR ALTERED WITHOUT PRIOR AGREEMENT FROM CIVILPLAN CONSULTANTS LIMITED. CIVILPLAN CONSULTANTS LIMITED WILL NOT ACCEPT LIABILITY ARISING FROM UNAUTHORISED USE OF THIS DRAWING.	

CIVILPLAN
CONSULTANTS

Level 9, Laidlaw House, 20 Amersham Way, Manukau, Auckland. Phone: 09 222 2445

PROJECT TITLE:

HUGHES DEVELOPMENTS LIMITED
99 ESCOTTS ROAD
TUAKAU

SHEET TITLE:

WASTEWATER ASBUILT
STAGE 2 - DETAIL SHEET 3
SUB0311/18 & LUC0489/18

ISSUE STATUS:


AS BUILT

SCALE: (A1/A3) 1:250 / 1:500

SCALE BAR 1:500@A3

DRAWING NUMBER: 2011-02-AB413

REV: A

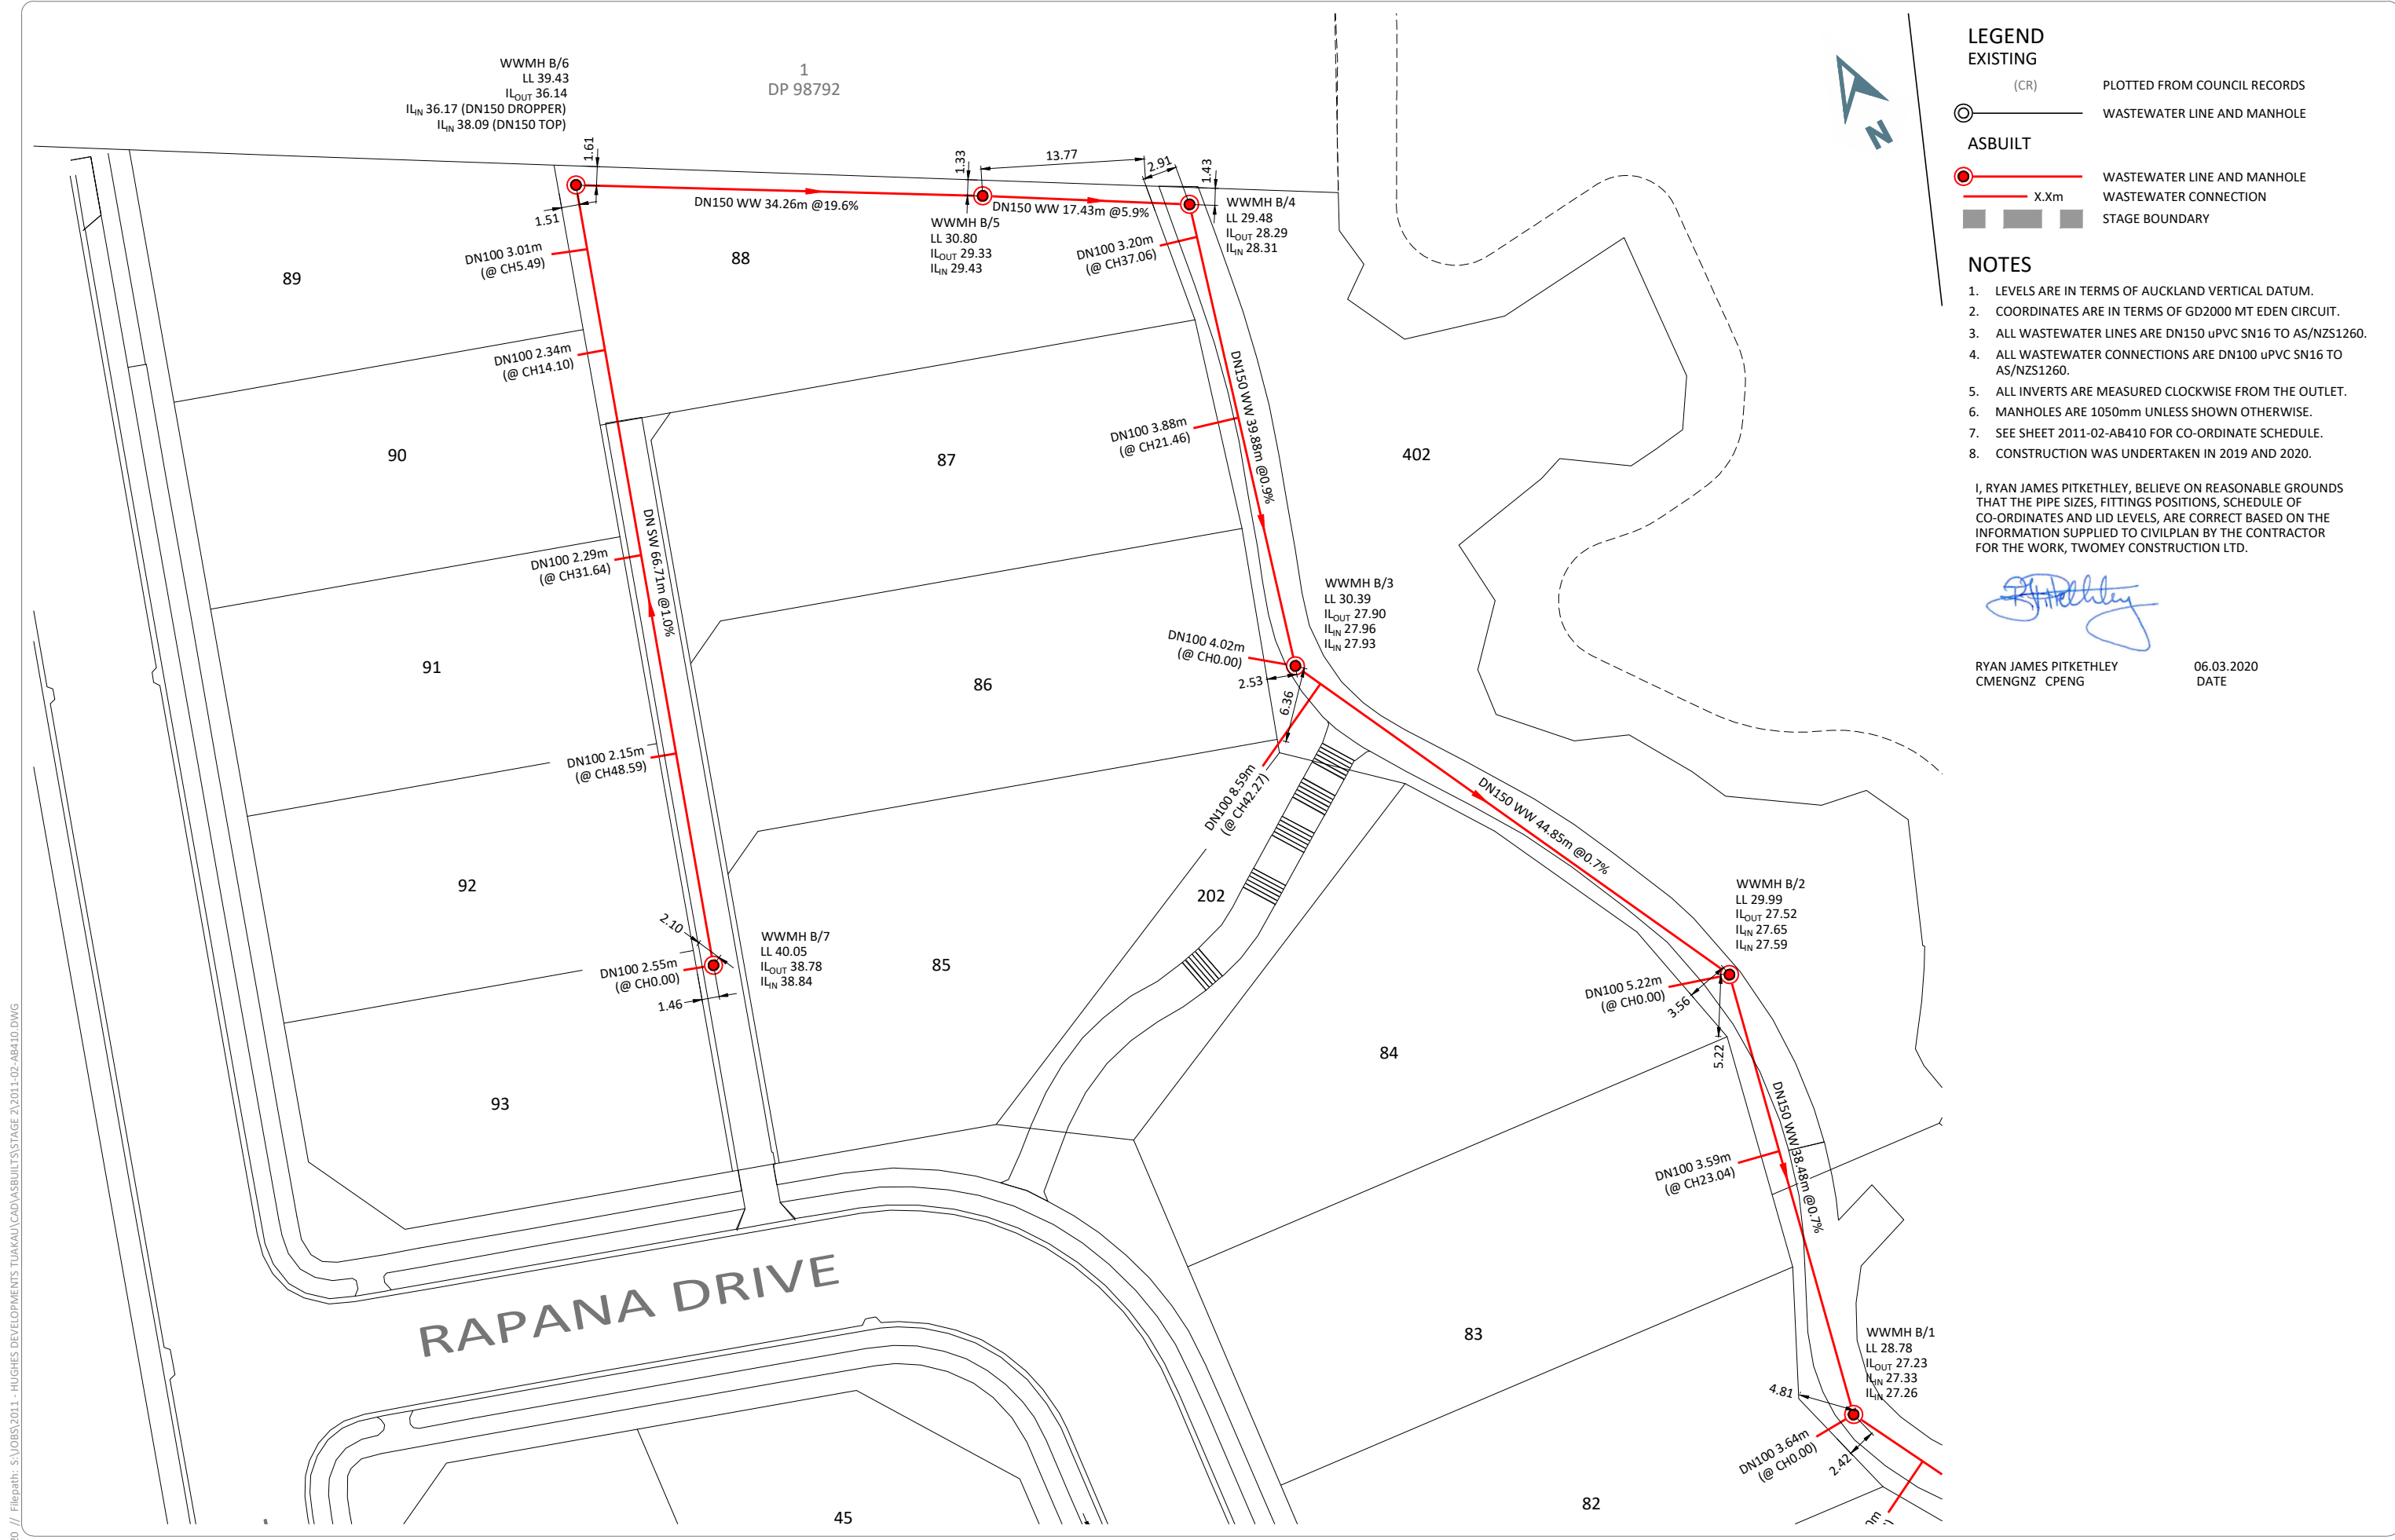

LEGEND

EXISTING
(CR) PLOTTED FROM COUNCIL RECORDS
WASTEWATER LINE AND MANHOLE

ASBUILT
WASTEWATER LINE AND MANHOLE
WASTEWATER CONNECTION
STAGE BOUNDARY


NOTES

- LEVELS ARE IN TERMS OF AUCKLAND VERTICAL DATUM.
- COORDINATES ARE IN TERMS OF GD2000 MT EDEN CIRCUIT.
- ALL WASTEWATER LINES ARE DN150 uPVC SN16 TO AS/NZS1260.
- ALL WASTEWATER CONNECTIONS ARE DN100 uPVC SN16 TO AS/NZS1260.
- ALL INVERTS ARE MEASURED CLOCKWISE FROM THE OUTLET.
- MANHOLES ARE 1050mm UNLESS SHOWN OTHERWISE.
- SEE SHEET 2011-02-AB410 FOR CO-ORDINATE SCHEDULE.
- CONSTRUCTION WAS UNDERTAKEN IN 2019 AND 2020.

I, RYAN JAMES PITKETHLEY, BELIEVE ON REASONABLE GROUNDS THAT THE PIPE SIZES, FITTINGS POSITIONS, SCHEDULE OF CO-ORDINATES AND LID LEVELS, ARE CORRECT BASED ON THE INFORMATION SUPPLIED TO CIVILPLAN BY THE CONTRACTOR FOR THE WORK, TWOMEY CONSTRUCTION LTD.

RYAN JAMES PITKETHLEY
CMENGNZ CPENG

06.03.2020
DATE

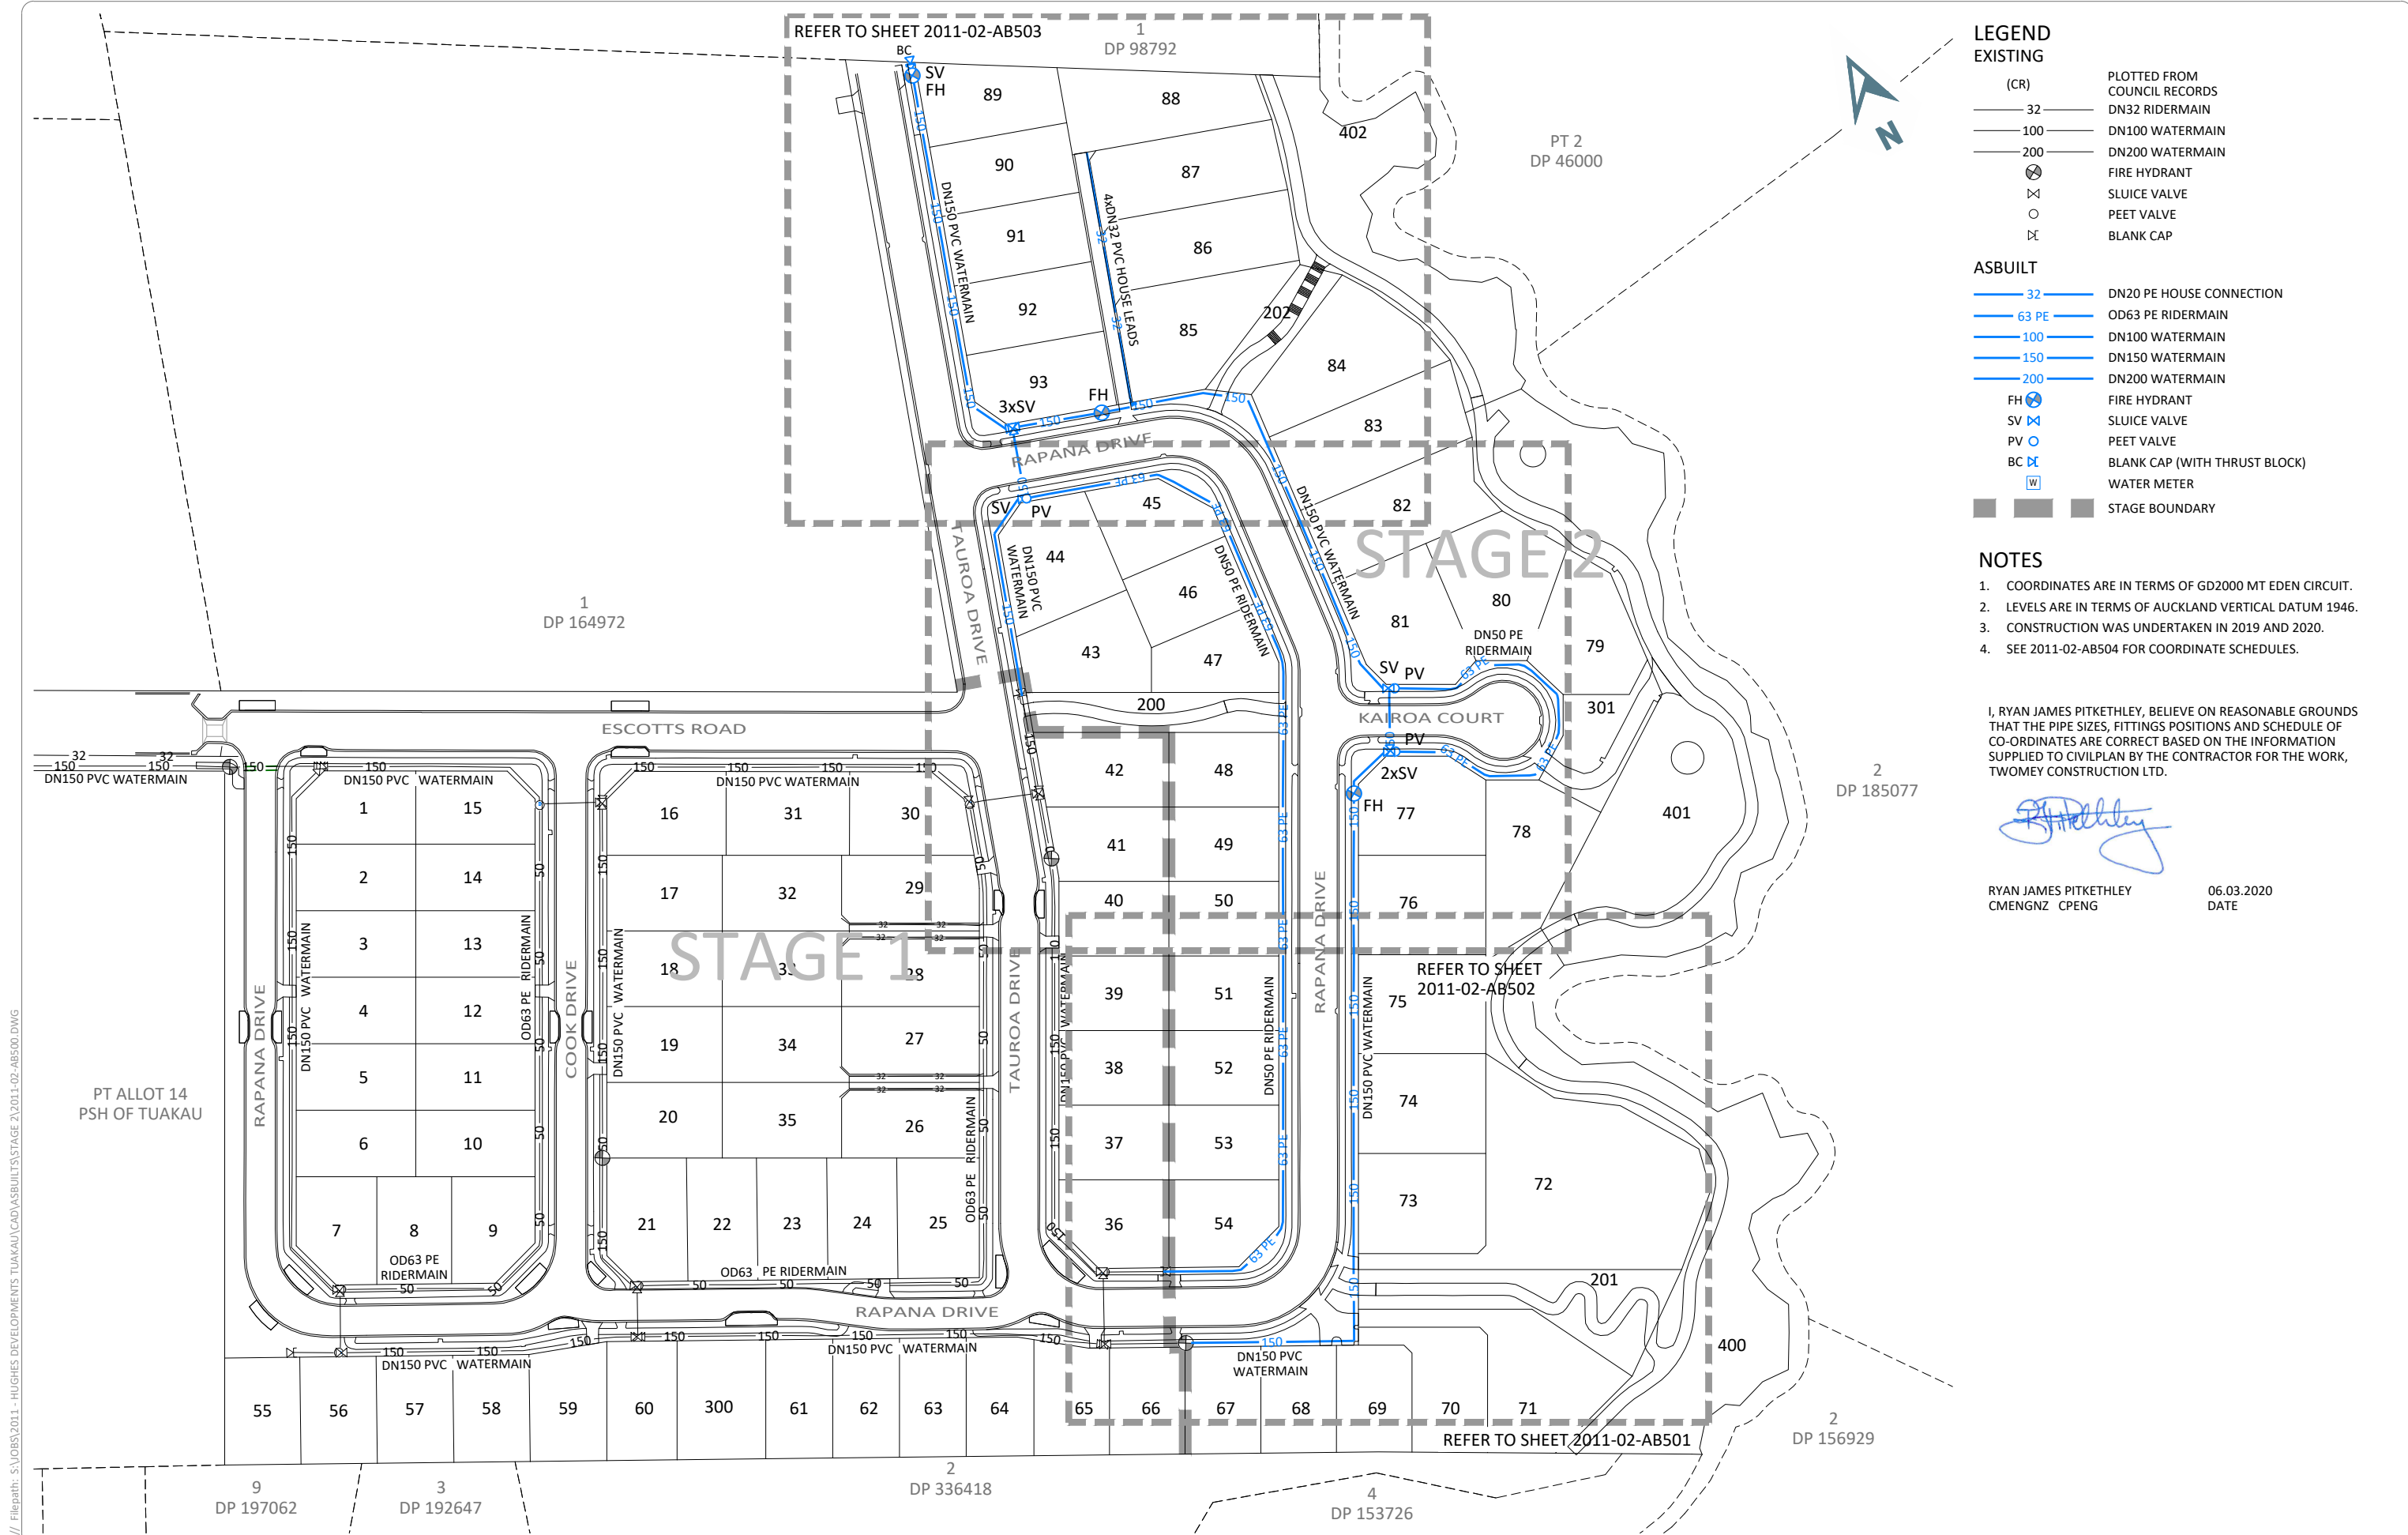

LEGEND

EXISTING

(CR)

32 — DN32 RIDERMAIN

100 — DN100 WATERMAIN

200 — DN200 WATERMAIN

⊗ — FIRE HYDRANT

⊠ — SLUICE VALVE

○ — PEET VALVE

⊞ — BLANK CAP

PLOTTED FROM COUNCIL RECORDS

ASBUILT

32 — DN20 PE HOUSE CONNECTION

63 PE — OD63 PE RIDERMAIN

100 — DN100 WATERMAIN

150 — DN150 WATERMAIN

200 — DN200 WATERMAIN

FH ⊗ — FIRE HYDRANT

SV ⊠ — SLUICE VALVE

PV ○ — PEET VALVE

BC ⊞ — BLANK CAP (WITH THRUST BLOCK)

W — WATER METER

■ — STAGE BOUNDARY

- NOTES**
- COORDINATES ARE IN TERMS OF GD2000 MT EDEN CIRCUIT.
 - LEVELS ARE IN TERMS OF AUCKLAND VERTICAL DATUM 1946.
 - CONSTRUCTION WAS UNDERTAKEN IN 2019 AND 2020.
 - SEE 2011-02-AB504 FOR COORDINATE SCHEDULES.

I, RYAN JAMES PITKETHLEY, BELIEVE ON REASONABLE GROUNDS THAT THE PIPE SIZES, FITTINGS POSITIONS AND SCHEDULE OF CO-ORDINATES ARE CORRECT BASED ON THE INFORMATION SUPPLIED TO CIVILPLAN BY THE CONTRACTOR FOR THE WORK, TWOMEY CONSTRUCTION LTD.


Ryan James Pitkethley

RYAN JAMES PITKETHLEY
CMENGNZ CPENG

06.03.2020
DATE

Printed by: RYAN@06.03.20 // Filepath: S:\085\2011 - HUGHES DEVELOPMENTS TUAKAU\CAD\ASBUILT\STAGE 2\2011-02-AB500.DWG

DRAWING DATE: 03.2020 CHECKED DATE: 06.03.20 APPROVED DATE: 06.03.20 THIS DRAWING (AND DESIGN) REMAINS THE PROPERTY OF CIVILPLAN CONSULTANTS LIMITED AND MAY NOT BE REPRODUCED OR ALTERED WITHOUT PRIOR AGREEMENT FROM CIVILPLAN CONSULTANTS LIMITED. CIVILPLAN CONSULTANTS LIMITED WILL NOT ACCEPT LIABILITY ARISING FROM UNAUTHORISED USE OF THIS DRAWING		CIVILPLAN CONSULTANTS Level 9, Laidlaw House, 20 Amersham Way, Manukau, Auckland. Phone: 09 222 2445		PROJECT TITLE: HUGHES DEVELOPMENTS LIMITED 99 ESCOTTS ROAD TUAKAU		SHEET TITLE: WATER SUPPLY ASBUILT PLAN STAGE 2 - OVERALL LAYOUT SUB0311/18 & LUC0489/18		ISSUE STATUS: SCALE: (A1/A3) 1:750 / 1:1500 SCALE BAR 0 15 30 45 60 75m DRAWING NUMBER: 2011-02-AB500 REV: A AS BUILT	
A AS BUILT ISSUE TR 06.03.20 BY DATE									

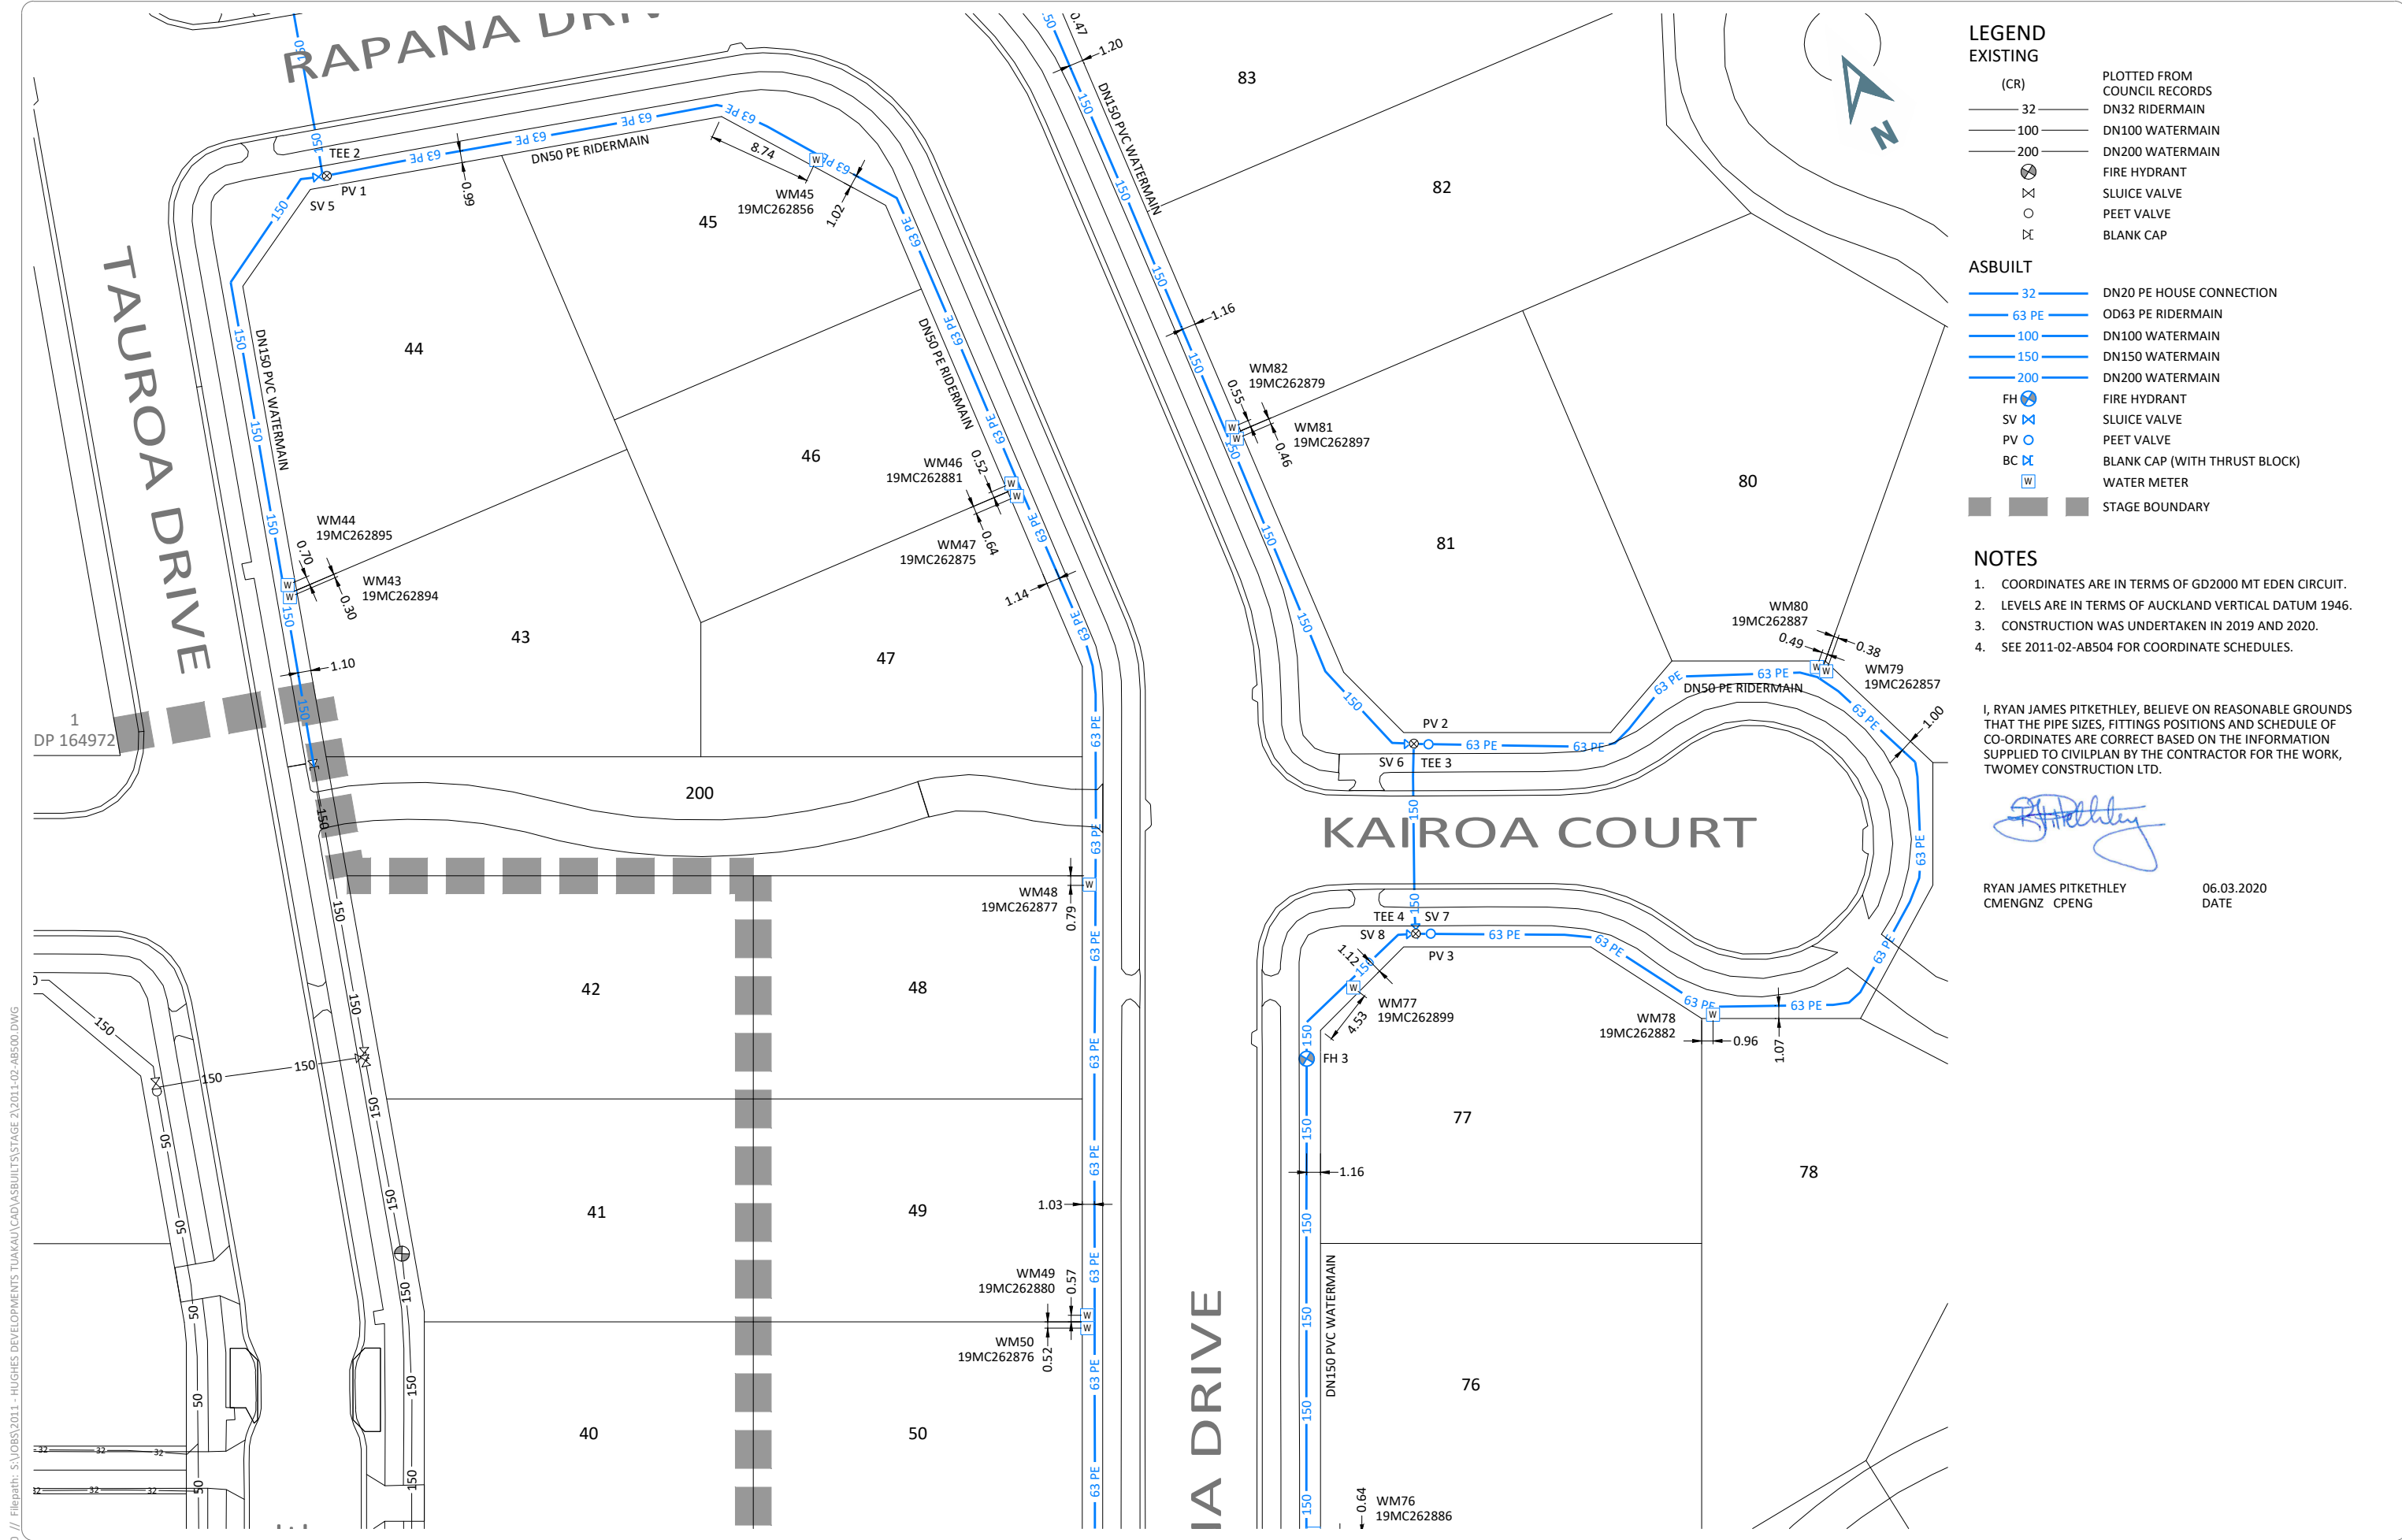

LEGEND

EXISTING

(CR)

— 32 —

— 100 —

— 200 —

PLOTTED FROM COUNCIL RECORDS

DN32 RIDERMAIN

DN100 WATERMAIN

DN200 WATERMAIN

FIRE HYDRANT

SLUICE VALVE

PEET VALVE

BLANK CAP

ASBUILT

DN20 PE HOUSE CONNECTION

OD63 PE RIDERMAIN

DN100 WATERMAIN

DN150 WATERMAIN

DN200 WATERMAIN

FIRE HYDRANT

SLUICE VALVE

PEET VALVE

BLANK CAP (WITH THRUST BLOCK)

WATER METER

STAGE BOUNDARY

- NOTES**
1. COORDINATES ARE IN TERMS OF GD2000 MT EDEN CIRCUIT.

2. LEVELS ARE IN TERMS OF AUCKLAND VERTICAL DATUM 1946.

3. CONSTRUCTION WAS UNDERTAKEN IN 2019 AND 2020.

4. SEE 2011-02-AB504 FOR COORDINATE SCHEDULES.

I, RYAN JAMES PITKETHLEY, BELIEVE ON REASONABLE GROUNDS THAT THE PIPE SIZES, FITTINGS POSITIONS AND SCHEDULE OF CO-ORDINATES ARE CORRECT BASED ON THE INFORMATION SUPPLIED TO CIVILPLAN BY THE CONTRACTOR FOR THE WORK, TWOMEY CONSTRUCTION LTD.

RYAN JAMES PITKETHLEY

CMENGNZ CPENG

06.03.2020

DATE

Printed by: RYAN@06.03.20 // Filepath: S:\JOBS\2011 - HUGHES DEVELOPMENTS TUAKAU\CAD\ASBUILT\STAGE 2\2011-02-AB500.DWG

A

AS BUILT ISSUE

TR5

06.03.20

REV

REVISION DETAILS

BY

DATE

DRAWN: DKP

DATE: 03.2020

CHECKED: RJP

DATE: 06.03.20

APPROVED: RJP

DATE: 06.03.20

THIS DRAWING (AND DESIGN) REMAINS THE PROPERTY OF CIVILPLAN CONSULTANTS LIMITED AND MAY NOT BE REPRODUCED OR ALTERED WITHOUT PRIOR AGREEMENT FROM CIVILPLAN CONSULTANTS LIMITED. CIVILPLAN CONSULTANTS LIMITED WILL NOT ACCEPT LIABILITY ARISING FROM UNAUTHORISED USE OF THIS DRAWING.

CIVILPLAN

CONSULTANTS

Level 9, Laidlaw House, 20 Amersham Way, Manukau, Auckland. Phone: 09 222 2445

PROJECT TITLE:

HUGHES DEVELOPMENTS LIMITED

99 ESCOTTS ROAD

TUAKAU

SHEET TITLE:

WATER SUPPLY ASBUILT PLAN

STAGE 2 - DETAIL SHEET 2

SUB0311/18 & LUC0489/18

ISSUE STATUS:

AS BUILT

SCALE: (A1/A3)

1:250 / 1:500

SCALE BAR

1:500@A3

0 5 10 15 20 25m

DRAWING NUMBER:

2011-02-AB502

REV:

A

Printed by: RYAN@06.03.20 // Filepath: S:\085\2011 - HUGHES DEVELOPMENTS TUAKAU\CAD\ASBUILT\STAGE 2\2011-02-AB500.DWG

A	AS BUILT ISSUE	TR	06.03.20
REV	REVISION DETAILS	BY	DATE

DRAWN:	DATE:
DKP	03.2020
CHECKED:	DATE:
RJP	06.03.20
APPROVED:	DATE:
RJP	06.03.20
THIS DRAWING (AND DESIGN) REMAINS THE PROPERTY OF CIVILPLAN CONSULTANTS LIMITED AND MAY NOT BE REPRODUCED OR ALTERED WITHOUT PRIOR AGREEMENT FROM CIVILPLAN CONSULTANTS LIMITED. CIVILPLAN CONSULTANTS LIMITED WILL NOT ACCEPT LIABILITY ARISING FROM UNAUTHORISED USE OF THIS DRAWING.	

CIVILPLAN
CONSULTANTS

Level 9, Laidlaw House, 20 Amersham Way, Manukau, Auckland. Phone: 09 222 2445

PROJECT TITLE:

HUGHES DEVELOPMENTS LIMITED
99 ESCOTTS ROAD
TUAKAU

SHEET TITLE:

WATER SUPPLY ASBUILT PLAN
STAGE 2 - DETAIL SHEET 3
SUB0311/18 & LUC0489/18

ISSUE STATUS:

AS BUILT

SCALE: (A1/A3) 1:250 / 1:500

SCALE BAR 1:500@A3 0 5 10 15 20 25m

DRAWING NUMBER: 2011-02-AB503 REV: A



LEGEND

EXISTING

(CR)

32

100

200

FH

SV

PV

BC

W

DN32 RIDERMAIN

DN100 WATERMAIN

DN200 WATERMAIN

FIRE HYDRANT

SLUICE VALVE

PEET VALVE

BLANK CAP

ASBUILT

32

63 PE

100

150

200

FH

SV

PV

BC

W

DN20 PE HOUSE CONNECTION

OD63 PE RIDERMAIN

DN100 WATERMAIN

DN150 WATERMAIN

DN200 WATERMAIN

FIRE HYDRANT

SLUICE VALVE

PEET VALVE

BLANK CAP (WITH THRUST BLOCK)

WATER METER

STAGE BOUNDARY

- NOTES
1. COORDINATES ARE IN TERMS OF GD2000 MT EDEN CIRCUIT.
2. LEVELS ARE IN TERMS OF AUCKLAND VERTICAL DATUM 1946.
3. CONSTRUCTION WAS UNDERTAKEN IN 2019 AND 2020.
4. SEE 2011-02-AB504 FOR COORDINATE SCHEDULES.

I, RYAN JAMES PITKETHLEY, BELIEVE ON REASONABLE GROUNDS THAT THE PIPE SIZES, FITTINGS POSITIONS AND SCHEDULE OF CO-ORDINATES ARE CORRECT BASED ON THE INFORMATION SUPPLIED TO CIVILPLAN BY THE CONTRACTOR FOR THE WORK, TWOMEY CONSTRUCTION LTD.

Ryan James Pitkethley

RYAN JAMES PITKETHLEY
CMENG NZ CPENG 06.03.2020
DATE

SCHEDULE OF COORDINATES PEET VALVES-GD2000		
POINT No.	mE	mN
PV 1	416444.81	757223.23
PV 2	416503.92	757137.59
PV 3	416496.58	757123.46

SCHEDULE OF COORDINATES BLANK CAP-GD2000		
POINT No.	mE	mN
BC 1	416470.56	757333.22

1. COORDINATES ARE IN TERMS OF GD2000 MT EDEN CIRCUIT.
2. LEVELS ARE IN TERMS OF AUCKLAND VERTICAL DATUM 1946.
3. CONSTRUCTION WAS UNDERTAKEN IN 2019 AND 2020.

Shelley

ISSUE STATUS:	AS BUILT	
SCALE: (A1/A3)	NOT TO SCALE	
SCALE BAR N.T.S.		
DRAWING NUMBER:	2011-02-AB504	REV: A

DRAWN: DXP	DATE: 03.2020	
CHECKED: RJP	DATE: 06.03.20	
APPROVED: RJP	DATE: 06.03.20	

THIS DRAWING (AND DESIGN) REMAINS THE PROPERTY OF CIVILPLAN CONSULTANTS LIMITED. IT MAY NOT BE REPRODUCED OR ALTERED WITHOUT PRIOR AGREEMENT FROM CIVILPLAN CONSULTANTS LIMITED. CIVILPLAN CONSULTANTS LIMITED WILL NOT ACCEPT LIABILITY ARISING FROM UNAUTHORISED USE OF THIS DRAWING.




PROJECT TITLE:

HUGHES DEVELOPMENTS LIMITED
99 ESCOTTS ROAD
TUAKAU

SHEET TITLE:

**WATER SUPPLY ASBUILT PLAN
STAGE 2 - COORDINATE SCHEDULES
SUB0311/18 & LUC0489/18**

ISSUE STATUS:	AS BUILT	
SCALE: (A1/A3)	NOT TO SCALE	
SCALE BAR N.T.S.		
DRAWING NUMBER:	2011-02-AB504	REV: A

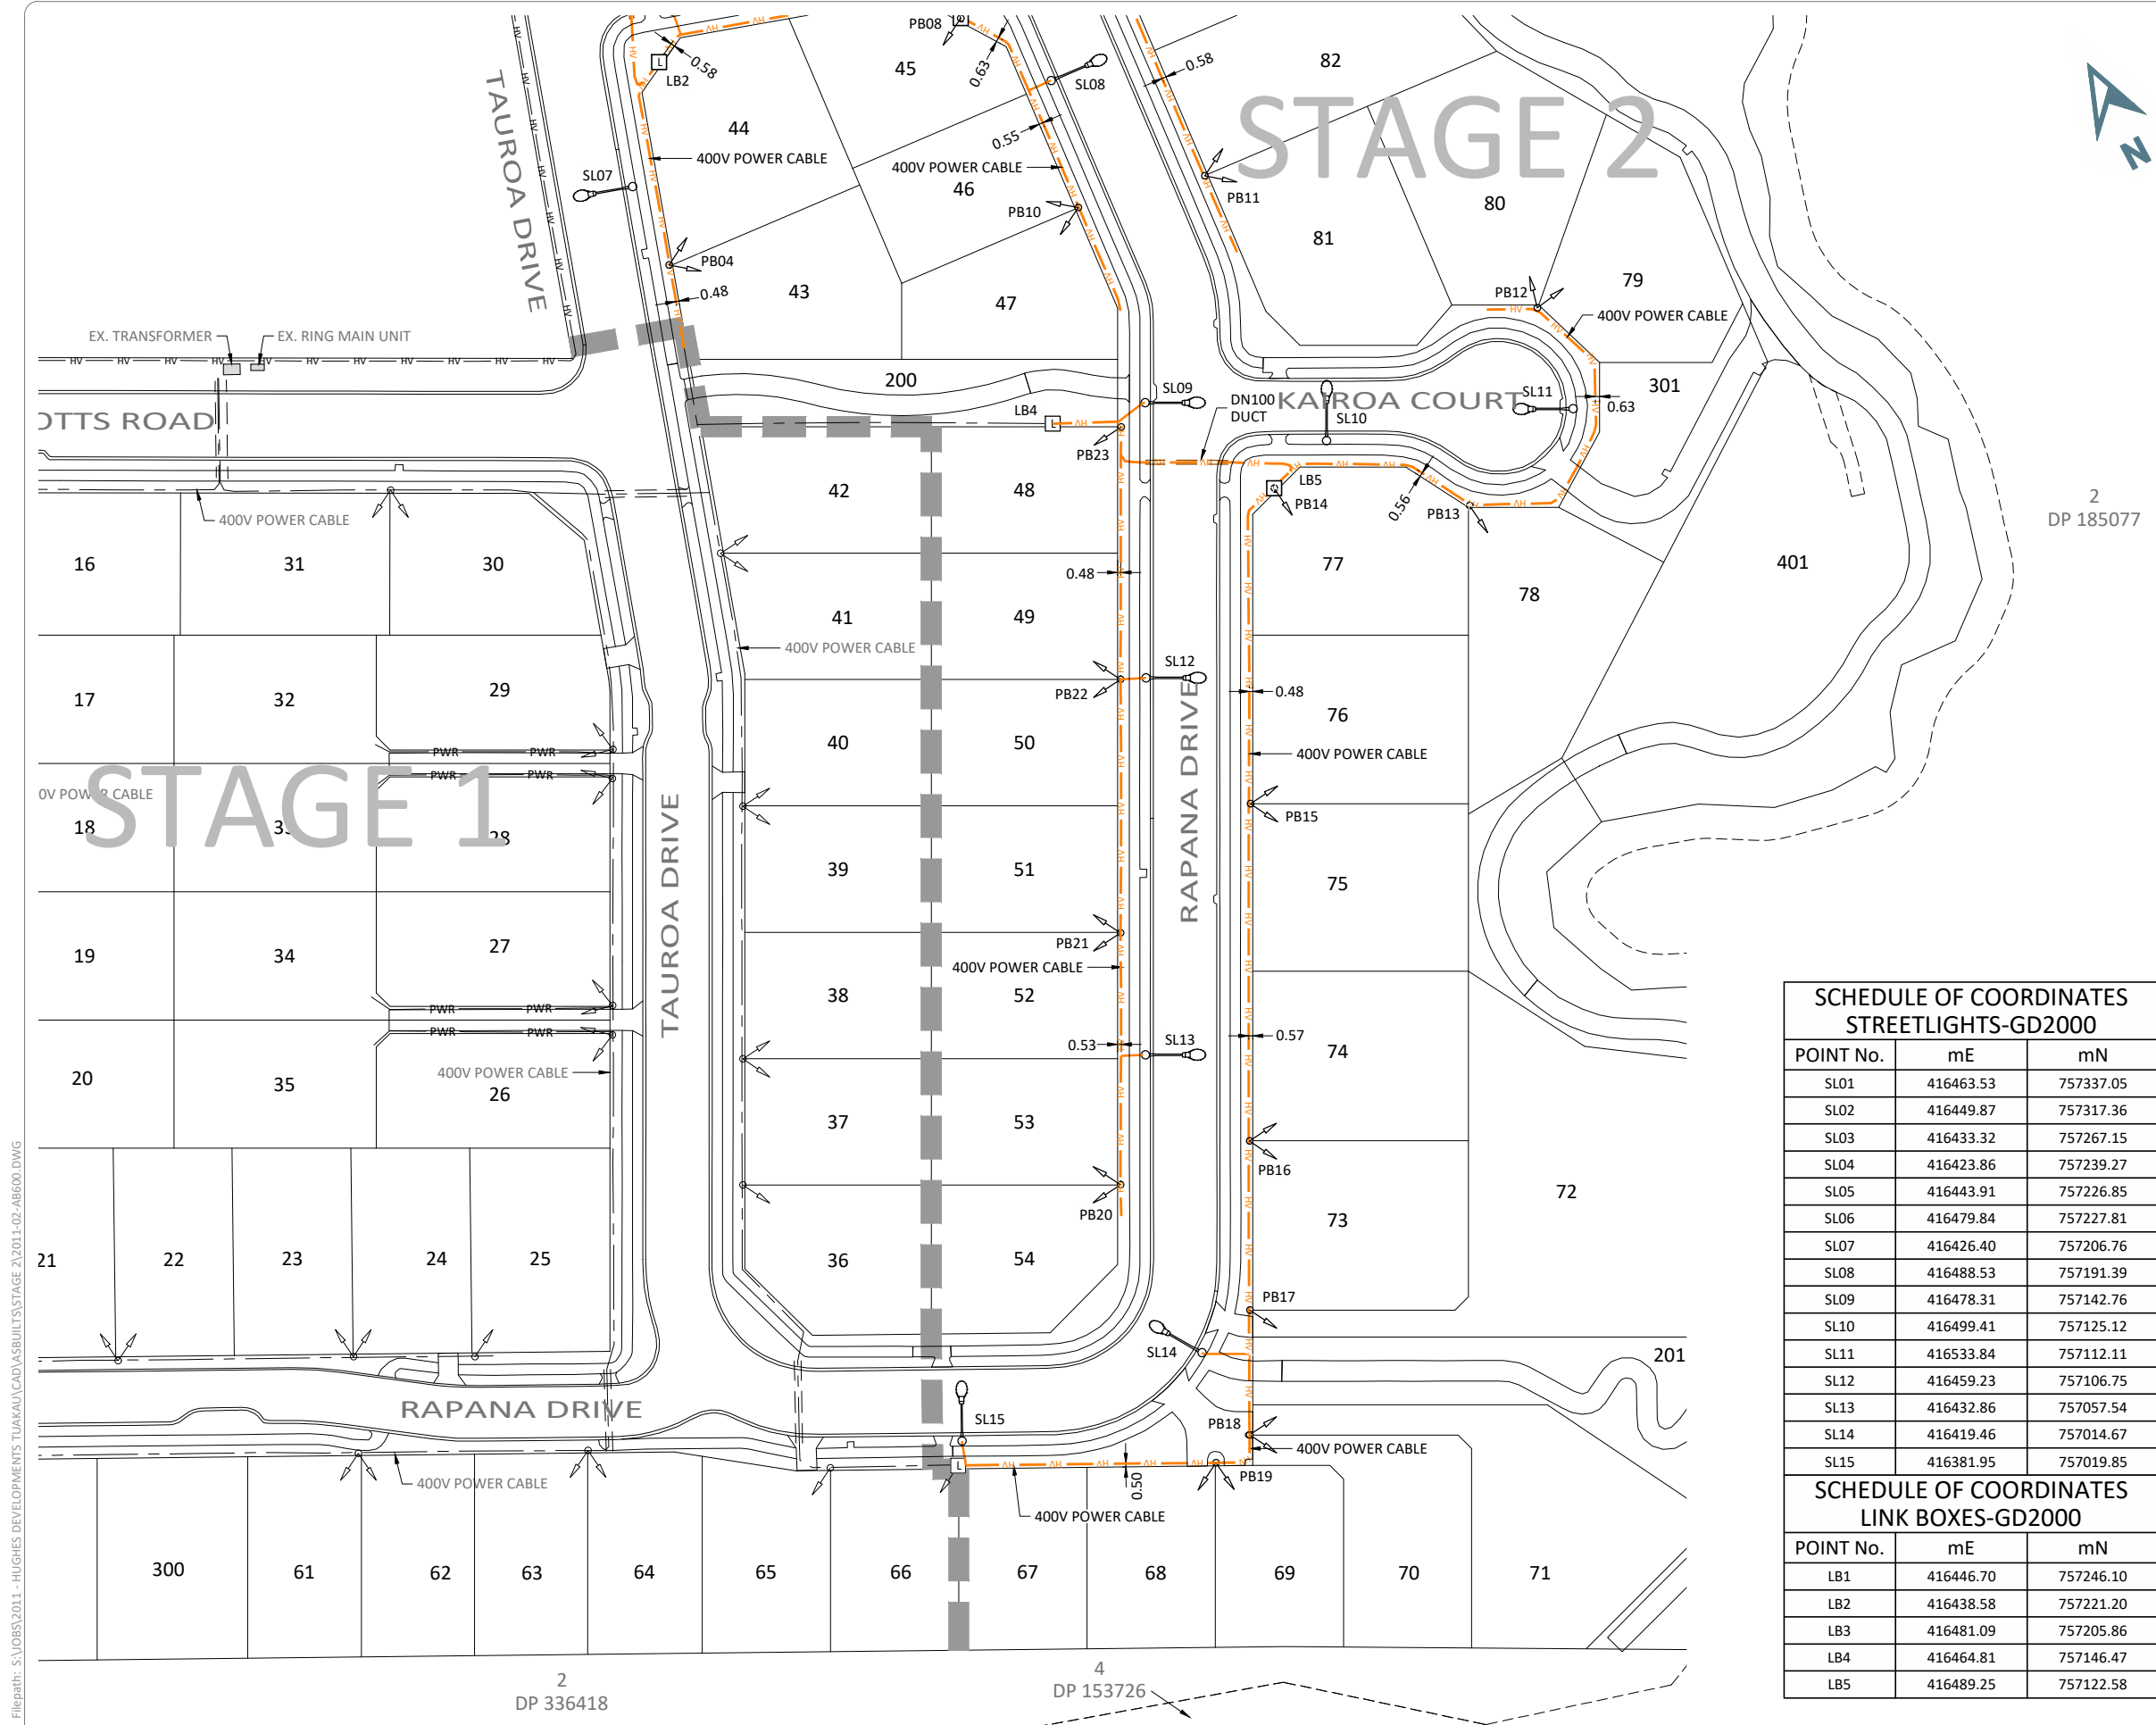

LEGEND

ASBUILT

PILLAR BOX

HV POWER CABLE

LV POWER CABLE

HOUSE POWER CABLE

DN100 PVC DUCT

STREETLIGHT

LINK BOX

EXISTING

PILLAR BOX

HV POWER CABLE

LV POWER CABLE

HOUSE POWER CABLE

DN100 PVC DUCT

STREETLIGHT

LINK BOX

RING MAIN UNIT

TRANSFORMER

NOTES

1. COORDINATES ARE IN TERMS OF GD2000 MT EDEN CIRCUIT.

2. CONSTRUCTION WAS UNDERTAKEN IN 2019 AND 2020.

I, RYAN JAMES PITKETHLEY, BELIEVE ON REASONABLE GROUNDS THAT THE PIPE SIZES, FITTINGS POSITIONS AND SCHEDULE OF CO-ORDINATES ARE CORRECT BASED ON THE INFORMATION SUPPLIED TO CIVILPLAN BY THE CONTRACTOR FOR THE WORK, TWOMEY CONSTRUCTION LTD.

RYAN JAMES PITKETHLEY
CMENGNZ CPENG

06.03.2020
DATE

SCHEDULE OF COORDINATES STREETLIGHTS-GD2000		
POINT No.	mE	mN
SL01	416463.53	757337.05
SL02	416449.87	757317.36
SL03	416433.32	757267.15
SL04	416423.86	757239.27
SL05	416443.91	757226.85
SL06	416479.84	757227.81
SL07	416426.40	757206.76
SL08	416488.53	757191.39
SL09	416478.31	757142.76
SL10	416499.41	757125.12
SL11	416533.84	757112.11
SL12	416459.23	757106.75
SL13	416432.86	757057.54
SL14	416419.46	757014.67
SL15	416381.95	757019.85

SCHEDULE OF COORDINATES LINK BOXES-GD2000		
POINT No.	mE	mN
LB1	416446.70	757246.10
LB2	416438.58	757221.20
LB3	416481.09	757205.86
LB4	416464.81	757146.47
LB5	416489.25	757122.58

SCHEDULE OF COORDINATES PILLAR BOXES-GD2000		
POINT No.	mE	mN
PB01	416464.42	757312.73
PB02	416458.88	757295.81
PB03	416447.89	757262.21
PB04	416425.74	757193.96
PB05	416499.21	757292.52
PB06	416492.71	757272.76
PB07	416487.19	757255.77
PB08	416481.09	757205.86
PB09	416505.52	757208.08
PB10	416483.21	757172.94
PB11	416501.98	757168.22
PB12	416536.23	757127.78
PB13	416513.59	757106.66
PB14	416489.25	757122.58
PB15	416464.13	757082.98
PB16	416440.46	757039.00
PB17	416428.71	757016.88
PB18	416419.99	757000.60
PB19	416413.62	756999.32
PB20	416420.54	757042.31
PB21	416438.11	757075.19
PB22	416455.80	757108.32
PB23	416473.50	757141.26

Printed by: RYAN@06.03.20 // Filepath: S:\085\2011 - HUGHES DEVELOPMENTS TUAKAU\CAD\ASBUILT\STAGE 2\2011-02-AB600.DWG

A	AS BUILT ISSUE	TR	06.03.20
	REVISION DETAILS	BY	DATE


DRAWN:	DATE:
DKP	03.2020
CHECKED:	DATE:
RJP	06.03.20
APPROVED:	DATE:
RJP	06.03.20
THIS DRAWING (AND DESIGN) REMAINS THE PROPERTY OF CIVILPLAN CONSULTANTS LIMITED AND MAY NOT BE REPRODUCED OR ALTERED WITHOUT PRIOR AGREEMENT FROM CIVILPLAN CONSULTANTS LIMITED. CIVILPLAN CONSULTANTS LIMITED WILL NOT ACCEPT LIABILITY ARISING FROM UNAUTHORISED USE OF THIS DRAWING.	


CIVILPLAN
CONSULTANTS
Level 9, Laidlaw House, 20 Amersham Way, Manukau, Auckland. Phone: 09 222 2445

PROJECT TITLE:
HUGHES DEVELOPMENTS LIMITED
99 ESCOTTS ROAD
TUAKAU

SHEET TITLE:
POWER SUPPLY ASBUILT PLAN
STAGE 2 - SHEET 2
SUB0311/18 & LUC0489/18

ISSUE STATUS: **AS BUILT**
SCALE: (A1/A3) 1:500 / 1:1000
SCALE BAR 0 10 20 30 40 50m
DRAWING NUMBER: 2011-02-AB601 REV: A

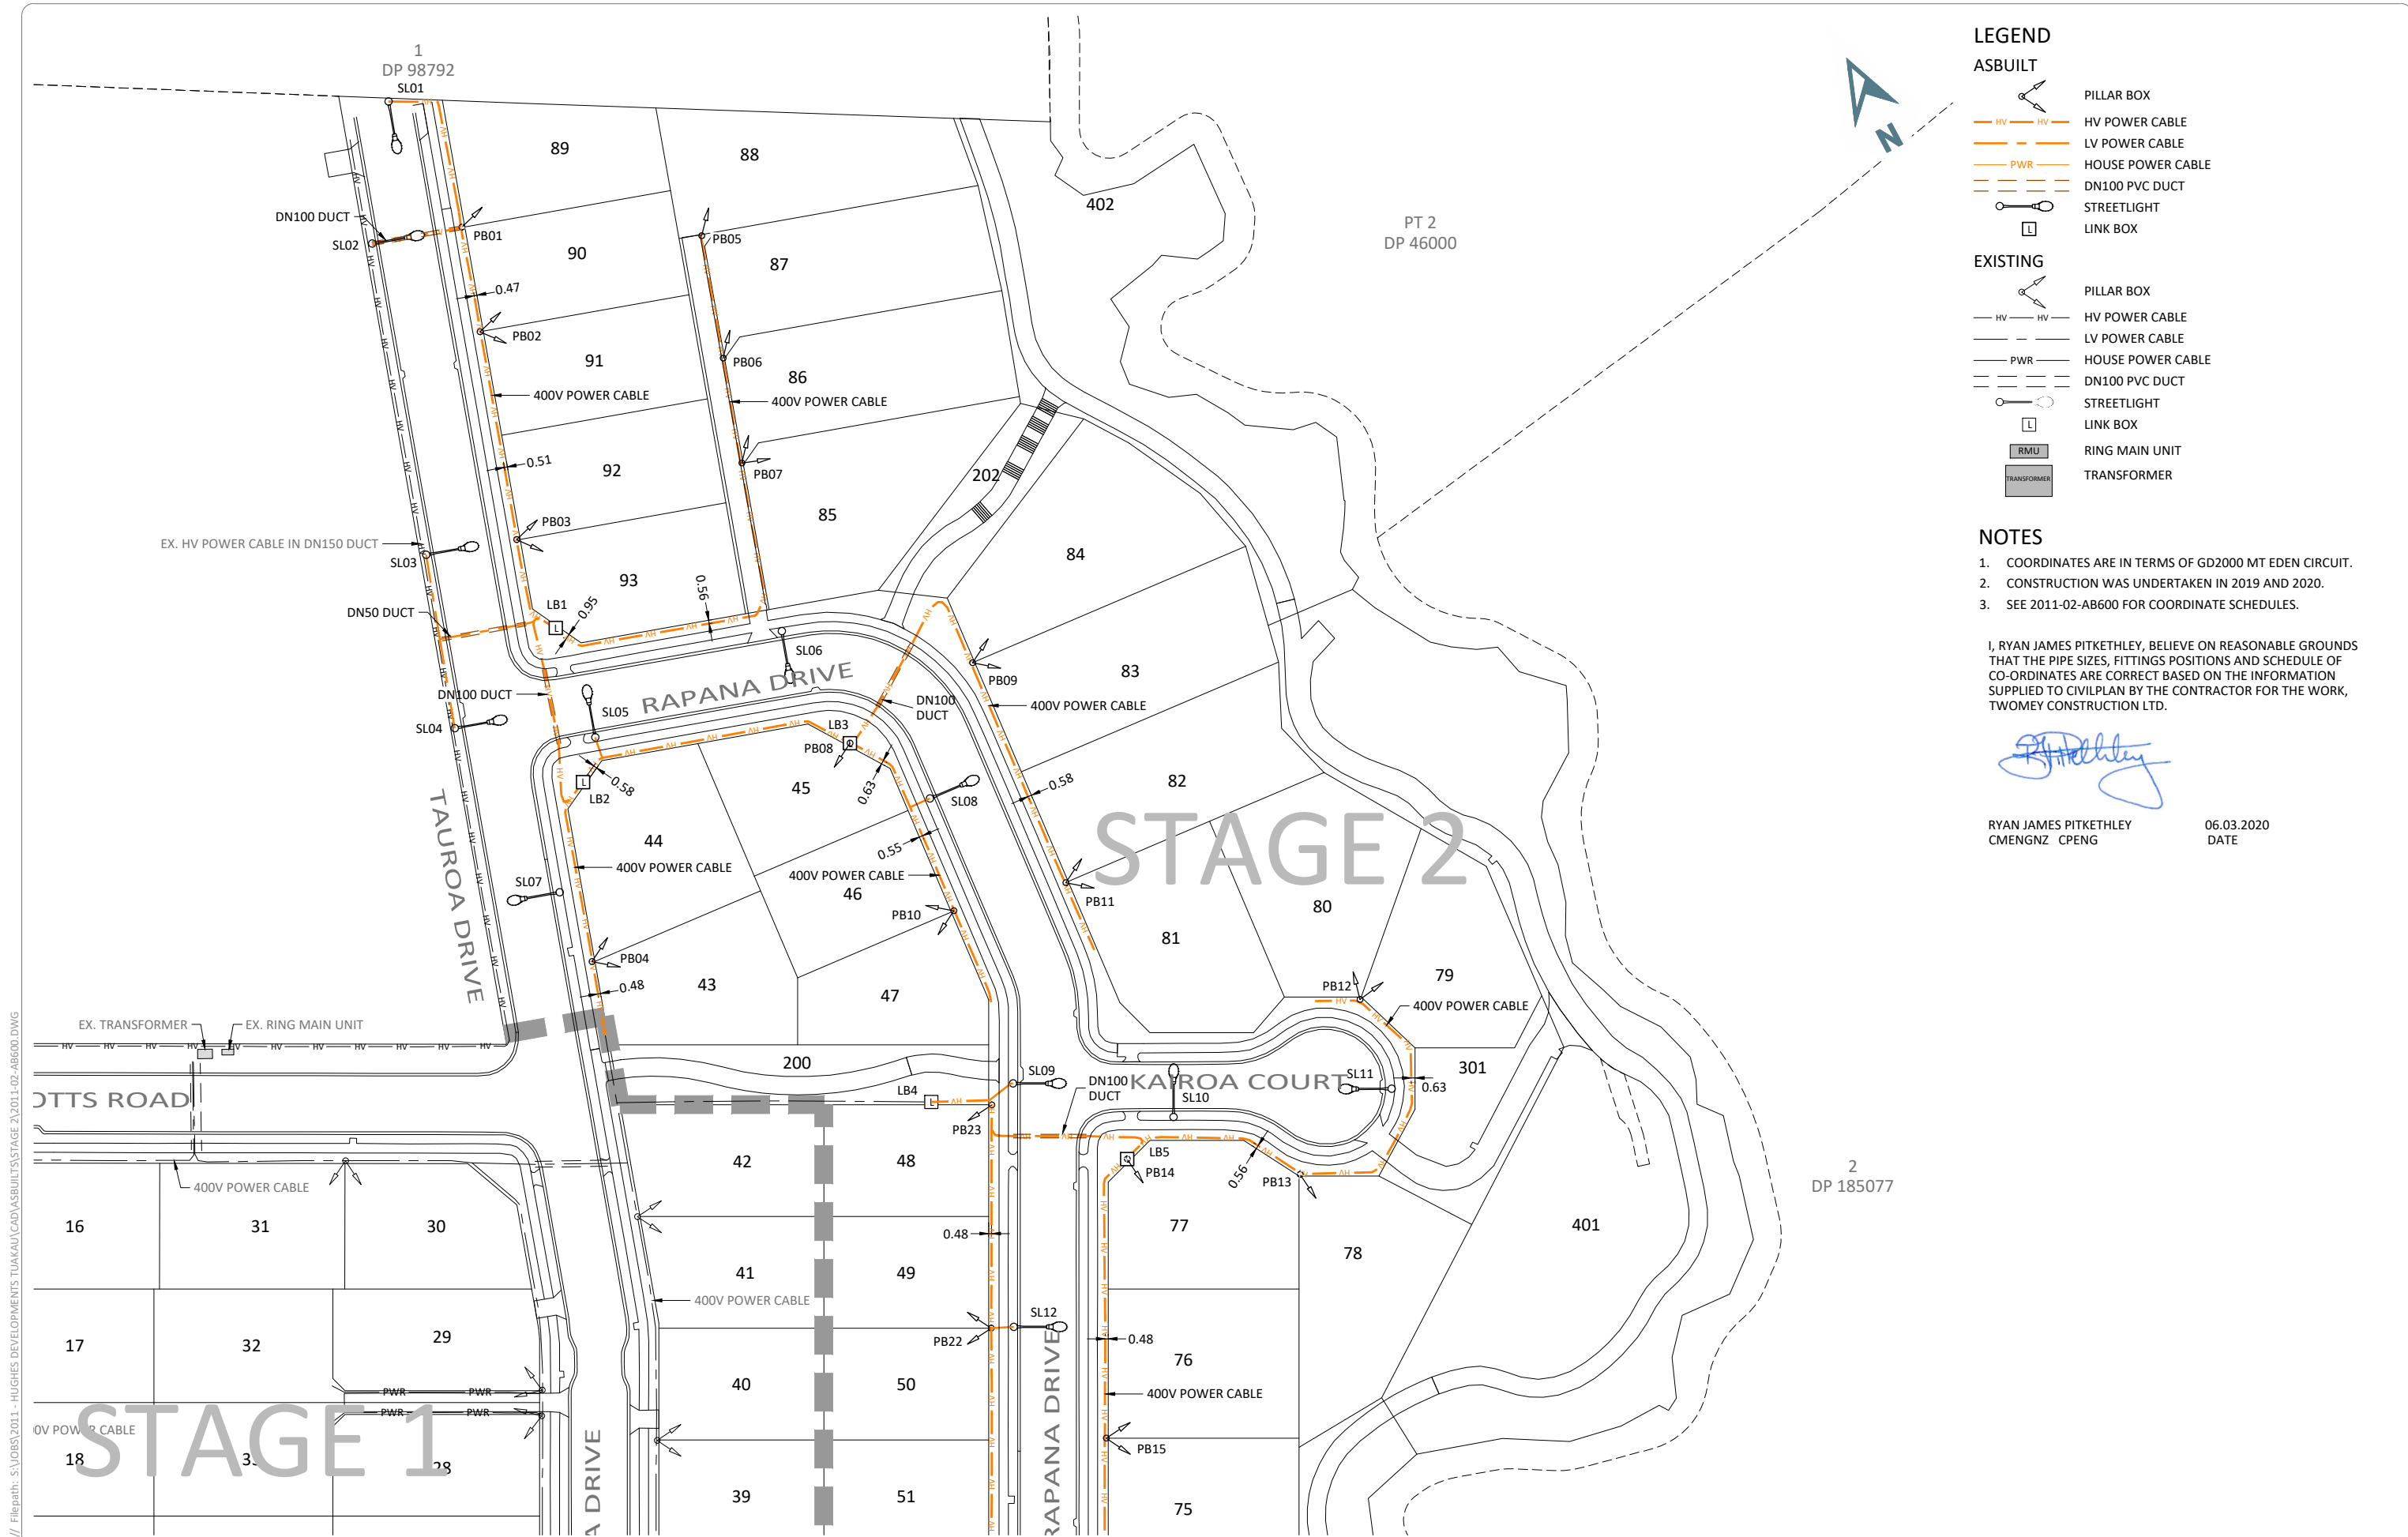

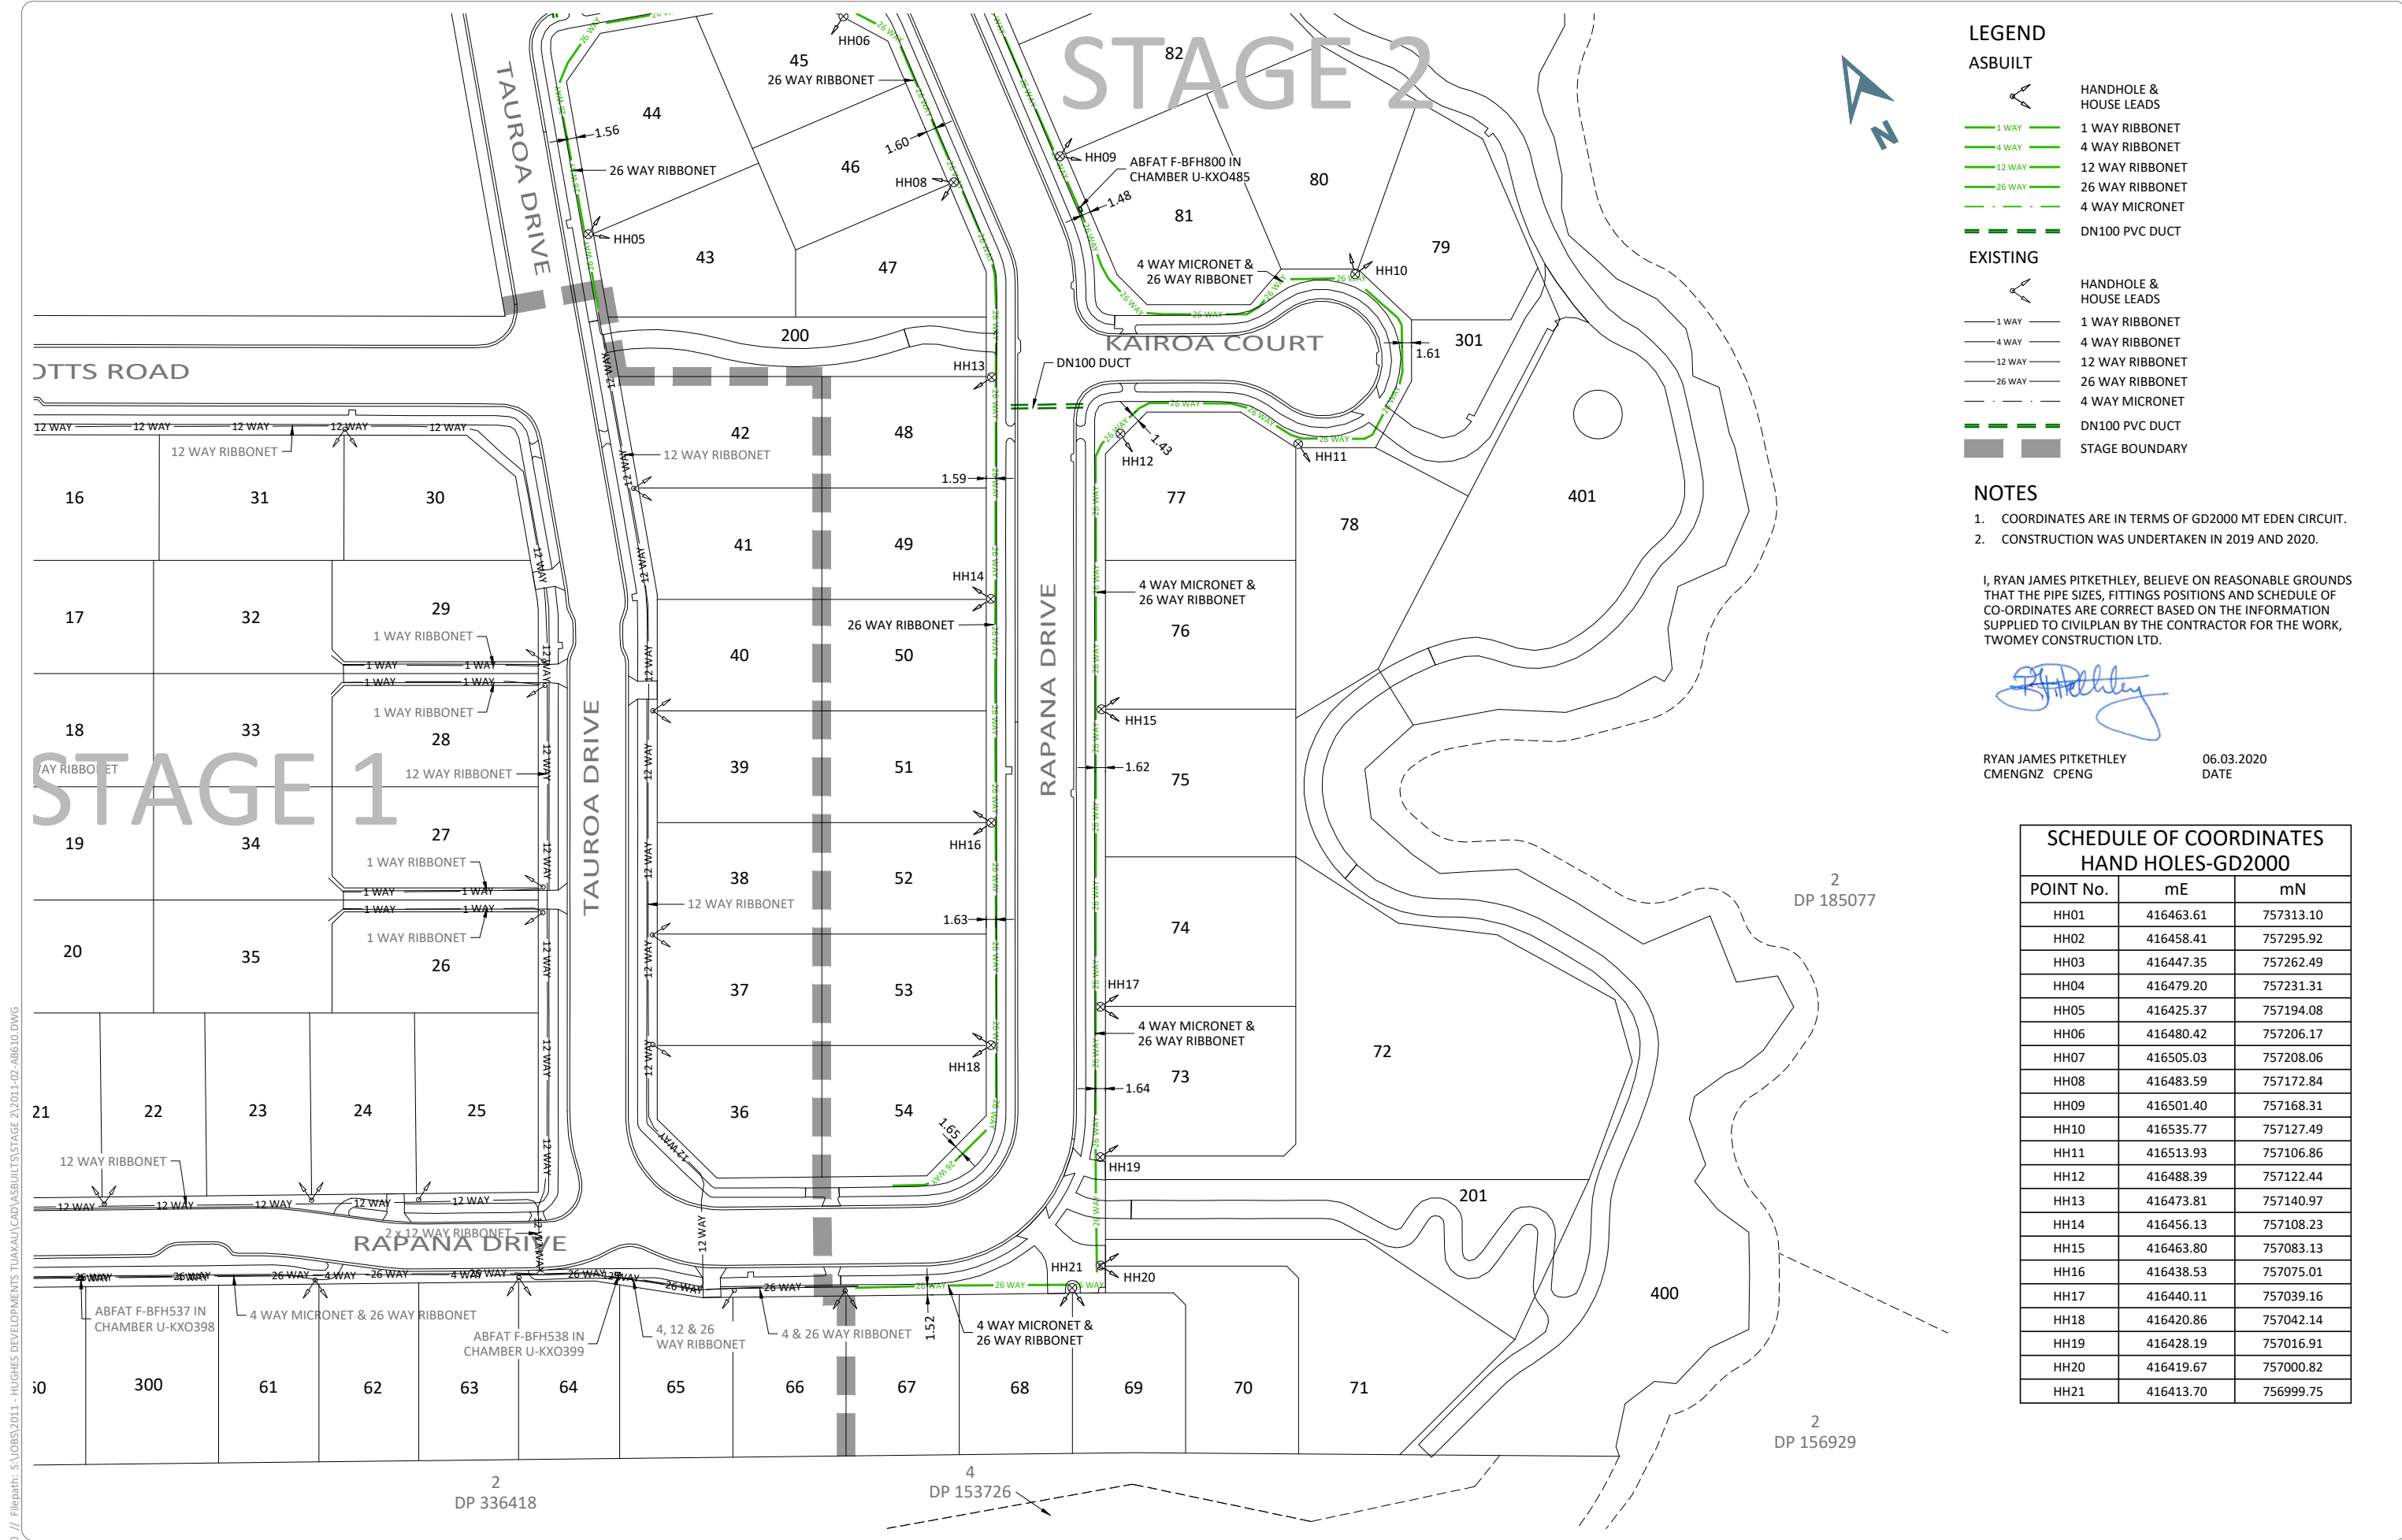

LEGEND

ASBUILT

1 WAY

4 WAY**EXISTING**

NOTES

1. COORDINATES ARE IN TERMS OF GD2000 MT EDEN CIRCUIT.

2. CONSTRUCTION WAS UNDERTAKEN IN 2019 AND 2020.

I, RYAN JAMES PITKETHLEY, BELIEVE ON REASONABLE GROUNDS THAT THE PIPE SIZES, FITTINGS POSITIONS AND SCHEDULE OF CO-ORDINATES ARE CORRECT BASED ON THE INFORMATION SUPPLIED TO CIVILPLAN BY THE CONTRACTOR FOR THE WORK, TWOMEY CONSTRUCTION LTD.

RYAN JAMES PITKETHLEY
CMENG NZ CPENG

06.03.2020
DATE

SCHEDULE OF COORDINATES HAND HOLES-GD2000		
POINT No.	mE	mN
HH01	416463.61	757313.10
HH02	416458.41	757295.92
HH03	416447.35	757262.49
HH04	416479.20	757231.31
HH05	416425.37	757194.08
HH06	416480.42	757206.17
HH07	416505.03	757208.06
HH08	416483.59	757172.84
HH09	416501.40	757168.31
HH10	416535.77	757127.49
HH11	416513.93	757106.86
HH12	416488.39	757122.44
HH13	416473.81	757140.97
HH14	416456.13	757108.23
HH15	416463.80	757083.13
HH16	416438.53	757075.01
HH17	416440.11	757039.16
HH18	416420.86	757042.14
HH19	416428.19	757016.91
HH20	416419.67	757000.82
HH21	416413.70	756999.75

Printed by: RYAN@06.03.20 // Filepath: S:\JOBS\2011 - HUGHES DEVELOPMENTS TUAKAU\CAD\ASBUILT\STAGE 2\2011-02-AB610.DWG

A	AS BUILT ISSUE	TR	06.03.20
REV	REVISION DETAILS	BY	DATE

DRAWN:	DATE:
DKP	03.2020
CHECKED:	DATE:
RJP	06.03.20
APPROVED:	DATE:
RJP	06.03.20

THIS DRAWING (AND DESIGN) REMAINS THE PROPERTY OF CIVILPLAN CONSULTANTS LIMITED AND MAY NOT BE REPRODUCED OR ALTERED WITHOUT PRIOR AGREEMENT FROM CIVILPLAN CONSULTANTS LIMITED. CIVILPLAN CONSULTANTS LIMITED WILL NOT ACCEPT LIABILITY ARISING FROM UNAUTHORISED USE OF THIS DRAWING

CIVILPLAN
CONSULTANTS

Level 9, Laidlaw House, 20 Amersham Way, Manukau, Auckland. Phone: 09 222 2445

PROJECT TITLE:

HUGHES DEVELOPMENTS LIMITED
99 ESCOTTS ROAD
TUAKAU

SHEET TITLE:

CHORUS ASBUILT PLAN
STAGE 2 - SHEET 1
SUB0311/18 & LUC0489/18

ISSUE STATUS:

AS BUILT

SCALE: (A1/A3) 1:500 / 1:1000

SCALE BAR 0 10 20 30 40 50m

DRAWING NUMBER: 2011-02-AB610 REV: A

Printed by: RYAN@06.03.20 // Filepath: S:\085\2011 - HUGHES DEVELOPMENTS TUAKAU\CAD\ASBUILT\STAGE 2\2011-02-AB610.DWG

A	AS BUILT ISSUE	TR	06.03.20
REV	REVISION DETAILS	BY	DATE

DRAWN:	DATE:
DKP	03.2020
CHECKED:	DATE:
RJP	06.03.20
APPROVED:	DATE:
RJP	06.03.20
THIS DRAWING (AND DESIGN) REMAINS THE PROPERTY OF CIVILPLAN CONSULTANTS LIMITED AND MAY NOT BE REPRODUCED OR ALTERED WITHOUT PRIOR AGREEMENT FROM CIVILPLAN CONSULTANTS LIMITED. CIVILPLAN CONSULTANTS LIMITED WILL NOT ACCEPT LIABILITY ARISING FROM UNAUTHORISED USE OF THIS DRAWING.	

CIVILPLAN
CONSULTANTS

Level 9, Laidlaw House, 20 Amersham Way, Manukau, Auckland. Phone: 09 222 2445

PROJECT TITLE:

HUGHES DEVELOPMENTS LIMITED
99 ESCOTTS ROAD
TUAKAU

SHEET TITLE:

CHORUS ASBUILT PLAN
STAGE 2 - SHEET 2
SUB0311/18 & LUC0489/18

ISSUE STATUS:

AS BUILT

SCALE: (A1/A3) 1:500 / 1:1000

SCALE BAR 0 10 20 30 40 50m

DRAWING NUMBER: 2011-02-AB611

REV: A



LEGEND

ASBUILT

1 WAY

4 WAY

12 WAY

26 WAY

4 WAY MICRONET

DN100 PVC DUCT

HANDHOLE & HOUSE LEADS

1 WAY RIBBONET

4 WAY RIBBONET

12 WAY RIBBONET

26 WAY RIBBONET

4 WAY MICRONET

DN100 PVC DUCT

STAGE BOUNDARY

EXISTING

1 WAY

4 WAY

12 WAY

26 WAY

4 WAY MICRONET

DN100 PVC DUCT

STAGE BOUNDARY

HANDHOLE & HOUSE LEADS

1 WAY RIBBONET

4 WAY RIBBONET

12 WAY RIBBONET

26 WAY RIBBONET

4 WAY MICRONET

DN100 PVC DUCT

STAGE BOUNDARY

- NOTES
1. COORDINATES ARE IN TERMS OF GD2000 MT EDEN CIRCUIT.

2. CONSTRUCTION WAS UNDERTAKEN IN 2019 AND 2020.
- I, RYAN JAMES PITKETHLEY, BELIEVE ON REASONABLE GROUNDS THAT THE PIPE SIZES, FITTINGS POSITIONS AND SCHEDULE OF CO-ORDINATES ARE CORRECT BASED ON THE INFORMATION SUPPLIED TO CIVILPLAN BY THE CONTRACTOR FOR THE WORK, TWOMEY CONSTRUCTION LTD.

RYAN JAMES PITKETHLEY

CMENGZNZ CPENG

06.03.2020

DATE

SCHEDULE OF COORDINATES HAND HOLES-GD2000		
POINT No.	mE	mN
HH01	416463.61	757313.10
HH02	416458.41	757295.92
HH03	416447.35	757262.49
HH04	416479.20	757231.31
HH05	416425.37	757194.08
HH06	416480.42	757206.17
HH07	416505.03	757208.06
HH08	416483.59	757172.84
HH09	416501.40	757168.31
HH10	416535.77	757127.49
HH11	416513.93	757106.86
HH12	416488.39	757122.44
HH13	416473.81	757140.97
HH14	416456.13	757108.23
HH15	416463.80	757083.13
HH16	416438.53	757075.01
HH17	416440.11	757039.16
HH18	416420.86	757042.14
HH19	416428.19	757016.91
HH20	416419.67	757000.82
HH21	416413.70	756999.75